2026 Specialty Beverage Equipment & Technology Playbook

October 17, 2025

Table of Contents

Beverage Overview **4**
New Equipment Added **4**
Before Getting Started **4**
Utilizing the Order Guide **5**
Required Smallwares Kit **6**
CBB Restaurants **7**
CBB Current Restaurant Layout 7
CBB Equipment Installation 7
CBB Technology Overview 10
CBB Required & Optional Equipment 12
BDAP Restaurants **14**
BDAP Current Restaurant Layout 14
BDAP Equipment Installation 15
BDAP Technology Overview 17
BDAP Required & Optional Equipment 18
Parallel CBB Cell **19**
Parallel CBB Cell Current Restaurant Layout 19
Parallel CBB Cell Equipment Installation 19
Parallel CBB Cell Technology Overview 22
Parallel CBB Cell Required Equipment 22
Other Restaurants (In-Store/Non-DT, Oil-Alliance, Walmart) **22**
Equipment Installation 23
Other Layouts Required Equipment 25
Technology Overview 25
Equipment Readiness Checklist **26**
CBB Checklist 26
BDAP Checklist 27
Detailed Plans/Layouts **28**
CBB Layouts 28

BDAP Layouts 32
Parallel CBB Layouts 35
In-Store/Non-DT Layouts 39
Gas Station/Oil Alliance 46
Walmart 50

Beverage Overview

The US beverage category is driving overall IEO growth – beverage growth outpaced overall IEO growth in 2024 (4.0% vs. 2.6%), and McDonald's is not currently capitalizing on this growth potential.

The goal is to establish McDonald's as a beverage destination, capitalizing on the growth tailwind in the beverage category, where beverages are a source of additional transactions and margin with nearly $3.9 billion of potential headroom.

This guide will walk you through the decision-making needed to set the restaurants up for success with the right equipment and layout. The goal is to provide the restaurant with an optimized layout that supports the creation of high-quality beverages and prioritizes consistency in taste across all restaurant service layouts.


New Equipment Added

To accommodate this Beverage Category extension, your restaurant will need to create countertop space to place new syrup racks, syrup pump bottles, inclusion containers, and potentially other small wares to make the new crafted beverages. To achieve this, existing equipment may need to be relocated, and in some cases, a new riser may need to be installed to capture both horizontal and vertical space. In some restaurant layout types, a POS register mounting arm will be required to move the POS off the countertop, allowing for more horizontal space for the new equipment and smallwares. Additionally, there will be preparation of water needed to accommodate a filler valve near your tea brewer, which will be used to prepare beverage bases. There will be potential electrical work if you choose to add an additional beverage monitor.

CBB 25 inch Refresher Station on 58 inch DT Cabinet



CBB 31 inch Refresher Station with OJ Table & 62.75 inch DT Cabinet

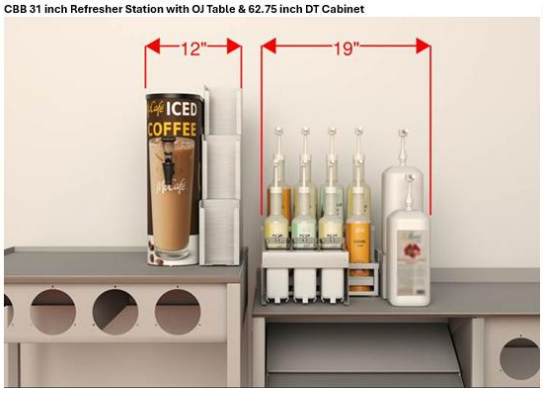

BDAP 37 inch Refresher Station



Before Getting Started

Note: This playbook is best used with a mobile device (tablet/laptop)

- It is **critical** that you review this playbook in detail and familiarize yourself with **all restaurant layouts** before completing the order guide **(pages 28-54)**
- You will need a tape measure and a mobile device to take pictures
- All installations are intended to be managed and completed by the owner/operator
- **Please note:** All restaurant layouts, including Walmart, Oil Alliance, and Special Venues, will be participating in the launch of specialty beverages unless legal requirements restrict participation

Utilizing the Order Guide

1. The online order guide will ask you to confirm your restaurant layout (BDAP, CBB, Parallel CBB, and other common layouts)
    a. When selecting your layout type, it is **critical** that you choose the one that **best aligns** with your restaurant. This will determine the equipment package that the KES will quote you
2. You will be asked a series of questions related to space and refrigeration
3. You will be asked questions related to your restaurant tech
4. You will then be asked to review and approve your final equipment order

Important note for sites under construction:

New Stores, Rebuilds, and Relos: Where construction will be completed by June 2026, please complete your survey guide as follows:

- Select BDAP for your layout and confirm that you have 37" of space (inclusive of an iced coffee urn) and adjacent refrigeration
    - If your new store is not a BDAP, select the appropriate layout type

Remodels: Where construction will be completed by June 2026, please complete your survey guide as follows:

- Remodels adding Full BDAP: Select BDAP for your layout and confirm that you have 37" of space (inclusive of an iced coffee urn) and adjacent refrigeration
- Remodels keeping CBB: Select CBB for your layout and answer questions based on current site conditions


Required Smallwares Kit

Shipment	Image	Description	QTY REQUIRED PER SITE
Smallwares Execution Kit		McFlurry S/Steel with plastic blue spoon -dragon fruit	2
Smallwares Execution Kit		1 Oz Perforated Inclusion Scoop-bursties	2
Smallwares Execution Kit		2L Square Pitcher with White Lid (Tall Pictcher)	8
Smallwares Execution Kit		Inclusion Containers With Lids	6
Smallwares Execution Kit		Ice Scoop	2
Smallwares Execution Kit		Ice Scoop Holder	1
Smallwares Execution Kit		New Spoodle - for strawberries	2
Smallwares Execution Kit		Cambro Storage Container	6
Smallwares Execution Kit		Cambro Storage Container Lid	6
Smallwares Execution Kit		Whisk	1
Smallwares Execution Kit		16 oz Measuring Cup	1

CBB Restaurants

CBB Current Restaurant Layout

- The layout below is a common layout for existing CBB restaurants
- The DT cabinet countertop is the portion of the layout impacted by the implementation of the new beverages. Below are a few key things you'll need to know about your restaurant before completing the order guide:
  - Confirm the countertop length in inches of your existing DT cabinet (highlighted in the red box). It is **crucial** to accurately measure this worktop, as this will determine your equipment package based on the provided layouts.
  - Does your existing DT cabinet have an ice bin?
  - Do you have a reach-in refrigerator underneath the OJ/POS table? (highlighted in the orange box).

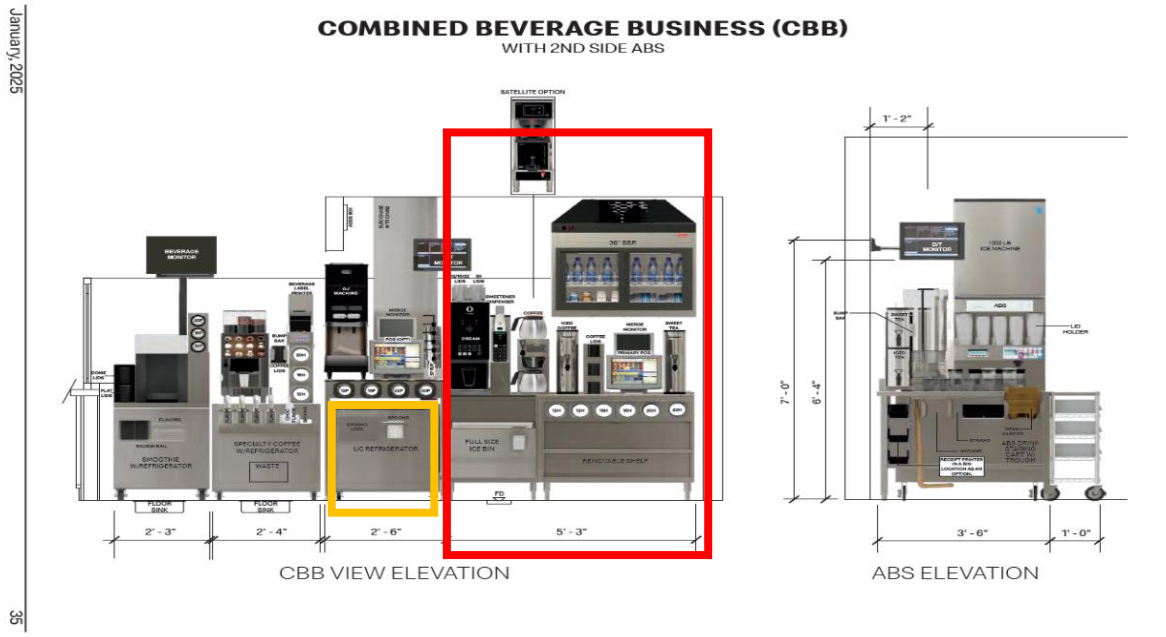

CBB Equipment Installation

All installations are intended to be managed and completed by the owner/operator.

❖ **Owner/Operator Responsibilities:**

- ➢ Familiarize yourself with the contents of the playbook
- ➢ Identify the restaurant layout
- ➢ Complete the KES online equipment order guide
- ➢ Approve your equipment order by the equipment ordering deadline
- ➢ Verify and obtain all required permitting and inspection requirements
- ➢ Coordinate completion of all utility work, installation of Beverage equipment needs, and reorganization of existing equipment pursuant to your individual restaurant layout as identified
- ➢ Follow the KES installation instructions for equipment and small wares (instructions and hardware packages will be provided for installation)

- **KES Responsibilities:**
  - Send out the Online Order Guide
  - Manufacture, consolidate, and ship equipment to support the O/O's installation
    - You will receive your equipment in two shipments – the first is the site readiness package, and the second is the small wares kit, closer to launch

- **Installation Requirements**
  - Remove BBR and make wall repairs (if necessary)
    - **Why you may need to remove your BBR**: If the BBR is located over the DT cabinet and equipment can't be re-sequenced to fit underneath the BBR, you will need to remove it to accommodate the new beverage equipment.
    - If BBR is removed, the product that is currently being stored there will need to be relocated to another refrigerator that is near the DT assembly or present area to minimize the additional steps for the crew. Please review the entire service area in your restaurant to determine the correct location to relocate these products.

  - Electrical Work
    - Schedule with local licensed Electrical Contractor (EC) and/or McD-approved General Contractor (GC) to coordinate with OO and OTP resource to:
      - Verify/relocate the location of isolated ground power outlets for any new technology that will be installed
      - Add power for reach-in refrigerator (if needed)
      - Verify/relocate the location of power is adequate for the relocated:
        - Sugar dispenser
        - POS (2)
        - Creamer
        - OJ
        - *GemX Narrow Brewer (if needed)*
          - *If you have 2 coffee brewers in your layout currently and you cannot fit both in the re-organized layout, you will need to order the Curtis GemX Narrow Brewer*
          - *This solution is most relevant to the 58" DT cabinet or smaller*
          - *If a GemX Narrow Brewer is ordered, appropriate electrical additions will need to be made to provide power for this equipment*

    Reminder, as stated in the equipment survey, a minimum of 2 coffee brewers is required. The GemX Narrow Brewer qualifies as 1 coffee brewer

  - Beverage Water Pre Work
    - **Note**: Water installation for this program includes a T-off from the chilled water line at the tea brewer and installing a Fisher Filler valve kit to dispense chilled water.
      - For restaurants without a multiplex: To ensure dispensed water meets the required temperature range of 36-40 F, restaurants will need an appropriate equipment solution. For guidance on equipment placement and available options, please contact your assigned KES representative.
    - **IMPORTANT**: The Tea Brewer will require a retrofit on the dilution line to be able to produce water to a Fisher Filler Valve to create beverage bases
    - **If you have a BUNN Tea Brewer**, you will receive a **"self-install" kit** to be assembled with the Fisher Filler Valve kit

- Self-Install Kit (Part# KIT-FISHER10003) & Fisher Filler Kit (Model# 2915-FG)
- This is intended to remove a Beverage Service Technician visit and allow the restaurant to execute in-house
- **Please utilize instructions here:** Beverage National BUNN Self Install Instructions.pdf

- **If you have a Curtis Tea Brewer**, you will be receiving **a service visit** from a **National Service Provider**
  - The following items are part of the equipment delivery:
    - Fisher 1704 Glass Filler Valve with Short Squeeze Lever & Fisher-Hose Food-Grade 60" (Model; 2915-FG)
    - The beverage vendor should be provided with this equipment upon their arrival at the store
    - Please review instructions here: Beverage National Curtis Install Instructions.pdf
- **Both Tea Brewers** will be receiving a **fabricated spigot holder** to mount on the Tea Brewer Table. Instructions are included in the individual install instructions
- Verify the integrity and connection of all lines for leaks. It is recommended to have shut-off valves for all new water lines

➢ Technology - If opting for an additional beverage monitor, validate placement of all necessary components (according to KES layouts on pages 28-54 and criteria on page 9)
- Monitor(s)
- Controller(s)
- Printer(s)
- Bump Bar(s)
- Applicable wires and brackets

➢ Reorganize Existing Equipment (according to KES layouts on pages 28-54)
- Coffee brewers
- OJ machine (if needed)
- POS Stations
- Creamer
- Sugar Dispenser
- Printer + Bump bar
- Monitor(s)
- Lid holder

**Note: Having a cash drawer at the DT present window area is not an approved operational standard. If you have a cash drawer on your DT cabinet, you will need to remove or relocate it to re-sequence your coffee equipment and create space for the beverage refresher station.*

➢ Equipment Install, Assembly, and Verification
- POS Mounting Arm Installation
  - **Why add POS Mounting Arms:** Within CBB layouts, we've found benefits to having the POS elevated in the beverage area. Elevating the POS creates additional space

on the counter for equipment. This is being required to help optimize crew workflow and improve overall beverage cell efficiency
    - Your GC will be responsible for installing the pole mount and arm. An OTP Pro will be required to relocate the POS system. Detailed instructions are currently being developed and will be distributed as soon as they become available.
    - If your POS register 14 or 15 is one of the below 3 models, additional mounting considerations are required. Please work with your OTP Pro/Elite and/or POS Vendor directly for proper installation and deployment to ensure readiness:
        - PAR WAVE (requires additional PAR bracket. Please reach out to inform your PAR supplier for the need of a K6151B)
        - PAR ES650 (requires additional PAR bracket. Please reach out to inform your PAR supplier for the need of a K6151B)
        - NCR CX7 (this is not a mountable POS system and will require a swap with a mountable POS register. Please work with your OTP Pro/Elite or POS vendor on applicable solutions)
- New Refresher Printer + Bump Bar Holder on Creamer (if installing new beverage monitor)
    - Relocate Printer and Bump Bar to the new Holder
- Refresher Station (Riser – if needed, Syrup Rail, Inclusion Holder, Refresher Pump Riser)
- Refresher Lid Holder
- New Base Refrigerator (if required)
- ABS2.0 Re-program – An enhanced software is available for ABS2.0 machines, which enables a "short pour" of the crafted sodas that have inclusions/add-ins. Additionally, this software is required to trigger the beverage to drop down within the ABS2.0 once it has been ordered

CBB Technology Overview

*All tech installations are intended to be managed and installed by **OTP Pros or Elite.** If unavailable, this will require a Professional install.*

Why You're Seeing the Option to Add a Beverage Monitor

- In some scenarios in the test, we've found benefits to having a second, dedicated beverage monitor in the beverage area. This option is being offered to help optimize crew workflow and improve overall beverage cell efficiency, if space allows at your location. **Please note:** Routing for all second CBB monitors will be split, with specific drinks going to a specific monitor. If the second CBB monitor is turned off, all beverages will route to the original CBB monitor.
- Some of the key benefits include:
    - Reduced cognitive load on crew members, allowing them to focus more effectively on their tasks
    - Placing the monitor in the exact location as the drink assembly area minimizes cross-over and reduces steps when multiple team members are working in the beverage cell, resulting in faster operations and less congestion
    - Easier for crew to step in and assist, especially during peak times
- If your restaurant can accommodate the additional monitor, we encourage you to consider adding one based on the criteria below to support smoother operations and better crew experience

➢ **Criteria Set**



- The guidance below was determined by MHQ UNSO leadership, based on data analysis and insights gathered from the AST and other relevant sources. You can identify the number of CBB Beverages you are currently selling by leveraging the QSRSoft Beverage Watch List.pdf

- If you are currently selling 30 CBB beverages in an hour at any point in the day, and **you have at least** the 12' 6" McCafe Station, we ***highly recommend purchasing*** a second beverage monitor
- If you are currently selling 30 CBB beverages in an hour at any point in the day, and you **don't have at least** the 12' 6" McCafe Station, we ***recommend purchasing*** a second beverage monitor
- If the maximum number of CBB items sold in an hour is 29 or fewer at any point during the day and you have at least the 12' 6" McCafe Station, we ***recommend planning for future growth*** and purchasing a second beverage monitor
- If the maximum number of CBB items sold in an hour is 29 or fewer at any point during the day, and you don't have at least the 12' 6" McCafe Station, we ***don't recommend*** having a second beverage monitor

Please note: CBB stores transitioning to a second beverage monitor will require additional components [e.g., bump bar, printer, cabling, controller, etc.] for a complete setup. Training materials are currently being developed for OTP Pros and Elites to enable self-installation, which will be formally announced when ready. You may also always contact your POS

supplier for additional guidance and a formal quote

- **Owner/Operator Responsibilities:**
  - Owner/Operator to review the playbook thoroughly and understand the criteria outline for determining whether to purchase an additional dedicated beverage monitor
  - Coordinate completion of all pre-electrical work if selecting to install new hardware
  - Ensure that a qualified individual within the organization is responsible for reaching out to your POS Vendor and ordering any required technology hardware and coordinating the installation process (e.g., with POS Vendor or OTP Pro or Elite)
  - Place order with POS Vendor for any necessary technology hardware to support the National Beverage rollout




- **POS Vendor Responsibilities:**
  - Provide a quote for new technology hardware upon request from the O/O
  - Ship necessary technology hardware to store(s)
  - Schedule the installation of new technology hardware, if the Owner/Operator has opted for professional installation

- **OTP Pro or Elite Responsibilities** (if owner/operator has opted for OTP installation)
  - Complete the initiative-specific OTP Pro training (link to final training when complete)
  - Install & configure all new beverage-specific technology hardware

CBB Required & Optional Equipment

Below is a list of equipment that comes with your CBB order and potential additions based on restaurant layout:


Shipment	Image	Description	QTY REQUIRED PER SITE
Site Readiness		3-Tier Lid Holder	1
Site Readiness		Refresher Station Riser Shelf	1
Site Readiness		Hardware/Install kit for Riser Shelf	1
Site Readiness		Refresher Station Syrup Rail	1
Site Readiness		3-Wide Inclusion Pan Holder	1

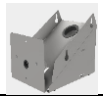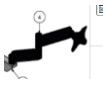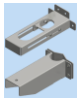Site Readiness		Large Bottle Riser Deck	1
Site Readiness		Printer Bump Bar Bracket	1
Site Readiness		Single Lid Holder	1
Site Readiness		Short Urns (QTY 1 auto quoted and additional ordered as needed)	1
Site Readiness		Complete Register Arm/Post Kit: *Includes: Register Arm, Arm Mount Bracket, Post w/ Surface Mount Bracket, Wall Support Bracket*	1
Site Readiness		Register Arm Retrofit Kit, for CBB Post *Includes: Register arm, Register Arm Bracket & CBB Wall Support Bracket*	1
Site Readiness		CBB Post and Wall Support Bracket	1
Site Readiness		Register Arm	1
Site Readiness		Register Arm Mounting Pole	1
Site Readiness		Mounting Pole Brackets (No Pole)	1
Site Readiness		Fisher Filler Valve Kit	1
Site Readiness		KBI Install Kit -Bunn Tea Brewers	1
Site Readiness		Tape, Plumbers 1/2 x 260 PTFEE	1
Site Readiness		Fisher Valve Tabletop Mount	1
Site Readiness		Bev Air 27" UCR LH Refrig	1
Site Readiness		True 27" UCR LH Refrig	1

BDAP Restaurants

BDAP Current Restaurant Layout

- The layouts below are common layouts for BDAP restaurants
- The BDAP will need to accommodate the new stations for the Beverage Launch. Below are a few key things you'll need to know about your restaurant prior to completing the order guide:
    - Can you create 37" of available space (inclusive of the existing iced coffee urn) on the countertop to accommodate the new refresher station? This refresher station must be adjacent to your existing ice bin (show layout example)
    - What type of refrigeration is located where the refresher station will go?
        - 2 drawer Cooler or Reach-in cooler

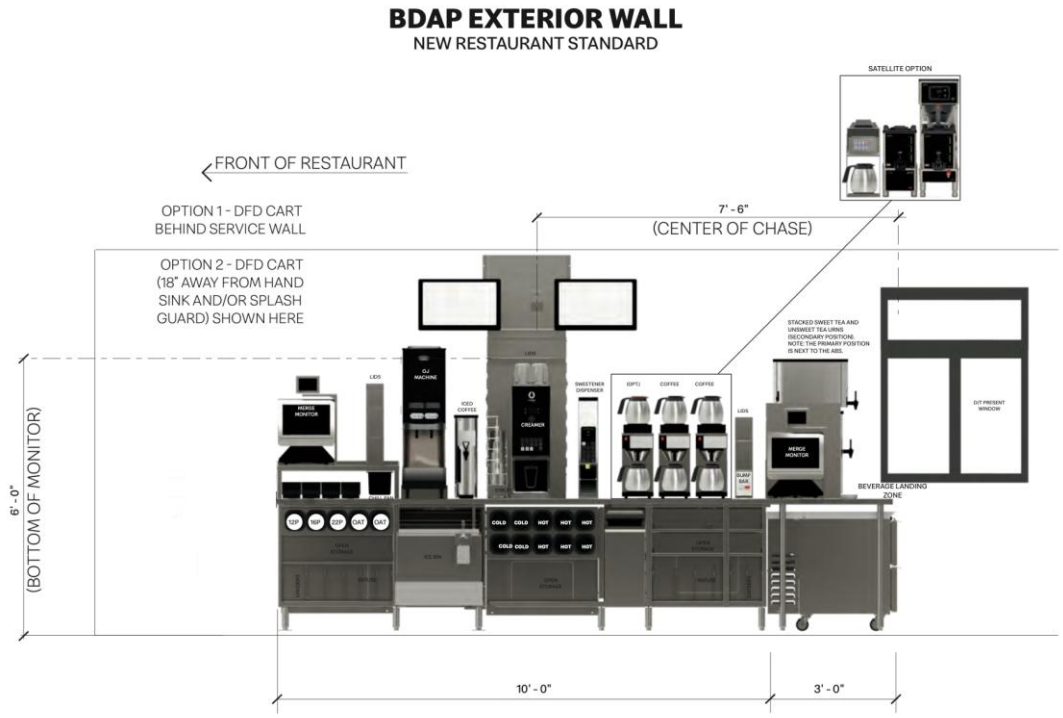

BDAP Equipment Installation

All installations are intended to be managed and installed by the owner/operator.

- **Owner/Operator Responsibilities:**
  - Familiarize yourself with the contents of the playbook
  - Identify the restaurant layout
  - Complete the KES online equipment order guide
  - Approve your equipment order by the equipment ordering deadline
  - Verify and obtain all required permitting and inspection requirements
  - Coordinate the completion of all utility work and the installation of your beverage equipment

- **KES Responsibilities:**
  - Send out the Online Order Guide
  - Manufacture, consolidate, and ship equipment to support the O/O's installation

- **Installation Requirements**
  - Electrical Work
    - Schedule with local licensed Electrical Contractor (EC) and/or McD approved General Contractor (GC) to coordinate with OO and OTP resource to:
      - Verify/relocate the location of isolated ground power outlets for any new technology that will be installed
      - Add/Relocate (or identify) the location of power for relocated:
        - Base Refrigerator
        - Sugar Dispenser
        - OJ
        - Creamer
        - Monitor (1 Merge) if needed
        - POS (2) if needed
        - Printers and Bump Bars

  - Beverage Water Pre Work
    - **Note:** Water installation for this program includes a T-off from the chilled water line at the tea brewer and installing a Fisher Filler valve kit to dispense chilled water.
      - For restaurants without a multiplex: To ensure dispensed water meets the required temperature range of 36-40 F, restaurants will need an appropriate equipment solution. For guidance on equipment placement and available options, please contact your assigned KES representative.
    - **IMPORTANT**: The Tea Brewer will require a retrofit on the dilution line to be able to produce water to a Fisher Filler Valve to create beverage bases
    - **If you have a BUNN Tea Brewer**, you will receive a **"self-install" kit** to be assembled with the Fisher Filler Valve kit
      - Self-Install Kit (Part# KIT-FISHER10003) & Fisher Filler Kit (Model# 2915-FG)
      - This is intended to remove a Beverage Service Technician visit and allow the restaurant to execute in-house
      - **Please utilize instructions here:** Beverage National BUNN Self-Install Instructions.pdf

- **If you have a Curtis Tea Brewer**, you will be receiving **a service visit** from a **National Service Provider**
    - The following items are part of the equipment delivery:
        - Fisher 1704 Glass Filler Valve with Short Squeeze Lever & Fisher-Hose Food-Grade 60" (Model; 2915-FG)
        - The beverage vendor should be provided with this equipment upon their arrival at the store
        - Please review instructions here: Beverage National Curtis Install Instructions.pdf
- **Both Tea Brewers** will be receiving a **fabricated spigot holder** to mount on the Tea Brewer Table. Instructions are included in the individual install instructions
- Verify the integrity and connection of all lines for leaks. It is recommended to have shut-off valves for all new water lines

➢ Technology - reference the KES layouts on pages 28-54 to determine if you will be required to add any necessary components to move to a split configuration
- Monitor(s)
- Controller(s)
- Printer(s)
- Bump Bar(s)
- Applicable wires and brackets

➢ Reorganize Existing Equipment (according to KES layouts on pages 28-54)
- Creamer
- OJ
- Lids
- Iced Bev
- Syrup
- Printer Shelf, Printer + Bump Bar
- Sugar Dispenser
- Lid Holder
- Refrigerator Table
- Base Refrigerator
- Tea Stand
- POS
- Iced Beverage
- Merge Monitor

**Note: Having a cash drawer at the DT present window area is not an approved operational standard. If you have a cash drawer on your DT cabinet, you will need to remove or relocate it to re-sequence your coffee equipment and create space for the beverage refresher station.*

➢ Equipment Install, Assembly, and Verification
- Refresher Station (Syrup Rail, Inclusion Holder, Refresher Pump Riser)
- Refresher Lid Holder
- New Refresher Printer + Bump Bar Holder on Creamer (if installing new beverage monitor)

- Relocate Printer and Bump Bar to the new Holder
- ABS Re-program

BDAP Technology Overview

All tech installations are intended to be managed and installed by OTP Pros. If unavailable, this will require a Professional install.

➢ **Why you are seeing instructions for needing to install new technology hardware**

- As part of the National rollout of the new specialty Beverages, BDAP restaurants that are currently set up as BDAP Mirrored will be required to convert to BDAP Split. To convert to this new standard setup, each side of the cell must have a KVS controller, monitor, printer and bump bar. Converting to a BDAP split allows for a reduced cognitive load for the crew, enabling them to focus on the menu items specific to their workstation. It also makes it easier for the crew to step in and assist, especially during peak times.

➢ **Owner/Operator Responsibilities:**

- Owner/Operator to review the playbook thoroughly and understand the criteria outline for determining whether to purchase an additional dedicated beverage monitor
- Coordinate completion of all pre-electrical work if selecting to install new hardware
- Ensure that a qualified individual within the organization is responsible for reaching out to the POS Vendor and ordering any required technology hardware and coordinating the installation process (e.g., with the POS Vendor or OTP Pro)
- Place order with POS Vendor for any necessary technology hardware to support the National Beverage rollout

➢ **POS Vendor Responsibilities:**


- Provide a quote for new technology hardware upon request from the O/O
- Ship necessary technology hardware to store(s)
- Schedule the installation of new technology hardware, if the Owner/Operator has opted for professional installation

➢ **OTP Pro or Elite Responsibilities** (if owner/operator has opted for OTP installation)

- Complete the initiative-specific OTP training (link to final training when complete)
- Install & configure all new beverage-specific technology hardware

BDAP Required & Optional Equipment

Below is a list of equipment that comes with your BDAP order and potential additions based on restaurant layout:

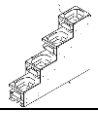Shipment	Image	Description	QTY REQUIRED PER SITE
Site Readiness		3-Tier Lid Holder	1
Site Readiness		3-Wide Inclusion Pan Holder	1
Site Readiness		Large Bottle Riser Deck	1
Site Readiness		4-Tier Syrup Bottle Rack	2
Site Readiness		Fisher Filler Valve Kit	1
Site Readiness		KBI Install Kit -Bunn Tea Brewers	1
Site Readiness		Tape, Plumbers 1/2 x 260 PTFEE	1
Site Readiness		Fisher Valve Tabletop Mount	1

Parallel CBB Cell

Parallel CBB Cell Current Restaurant Layout

- Reference the Parallel CBB Cell layouts on pages 36-39.
- The DT cabinet countertop is the portion of the layout impacted by the implementation of the new beverages. Below are a few key things you'll need to know about your restaurant before completing the order guide:
  - Confirm the countertop length in inches of your existing DT cabinet (highlighted in the red box). It is **crucial** to accurately measure this worktop, as this will determine your equipment package according to the provided layouts
  - Does your existing DT cabinet have an ice bin?
  - Do you have a reach-in refrigerator underneath the OJ/POS table?

Parallel CBB Cell Equipment Installation

All installations are intended to be managed and completed by the owner/operator.

❖ **Owner/Operator Responsibilities:**
- ➢ Familiarize yourself with the contents of the playbook
- ➢ Identify the restaurant layout
- ➢ Complete the KES online equipment order guide
- ➢ Approve your equipment order by the equipment ordering deadline
- ➢ Verify and obtain all required permitting and inspection requirements
- ➢ Coordinate completion of all utility work, installation of Beverage equipment needs, and reorganization of existing equipment pursuant to your individual restaurant layout as identified
- ➢ Follow the KES installation instructions for equipment and small wares (instructions and hardware packages will be provided for installation)

❖ **KES Responsibilities:**
- ➢ Send out the Online Order Guide
- ➢ Manufacture, consolidate, and ship equipment to support the O/O's installation
  - You will receive your equipment in two shipments – the first is the site readiness package, and the second is the small wares kit, closer to launch

❖ **Installation Requirements**
- ➢ Remove BBR and make wall repairs (if necessary)
  - **Why you may need to remove your BBR**: If the BBR is located over the DT cabinet and equipment can't be re-sequenced to fit underneath the BBR, you will need to remove it to accommodate the new beverage equipment.
  - If BBR is removed, the product that is currently being stored there will need to be relocated to another refrigerator that is near the DT assembly or present area to minimize the additional steps for the crew. Please review the entire service area in your restaurant to determine the correct location to relocate these products.
- ➢ Electrical Work

- Schedule with local licensed Electrical Contractor (EC) and/or McD-approved General Contractor (GC) to coordinate with OO and OTP resource to:
  - Verify/relocate the location of isolated ground power outlets for any new technology that will be installed
  - Add power for reach-in refrigerator (if needed)
  - Verify/relocate the location of power is adequate for the relocated:
    - Sugar dispenser
    - POS (2)
    - Creamer
    - OJ
    - *GemX Narrow Brewer (if needed)*
      - *If you have 2 coffee brewers in your layout currently and you cannot fit both in the re-organized layout, you will need to order the Curtis GemX Narrow Brewer*
      - *This solution is most relevant to the 58" DT cabinet.*
      - *If a GemX Narrow Brewer is ordered appropriate electrical additions will need to be made to provide power for this equipment.*

Reminder, as stated in the equipment survey, a minimum of 2 coffee brewers is required. The GemX Narrow Brewer qualifies as 1 coffee brewer

➢ Beverage Water Pre Work

- **Note:** Water installation for this program includes a T-off from the chilled water line at the tea brewer and installing a Fisher Filler valve kit to dispense chilled water.
  - For restaurants without a multiplex: To ensure dispensed water meets the required temperature range of 36-40 F, restaurants will need an appropriate equipment solution. For guidance on equipment placement and available options, please contact your assigned KES representative.
- **IMPORTANT**: The Tea Brewer will require a retrofit on the dilution line to be able to produce water to a Fisher Filler Valve to create beverage bases
- **If you have a BUNN Tea Brewer**, you will receive a **"self-install" kit** to be assembled with the Fisher Filler Valve kit
  - Self-Install Kit (Part# KIT-FISHER10003) & Fisher Filler Kit (Model# 2915-FG)
  - This is intended to remove a Beverage Service Technician visit and allow the restaurant to execute in-house
  - **nstructions here:** Beverage National BUNN Self Install Instructions.pdf
- **If you have a Curtis Tea Brewer**, you will be receiving **a service visit** from a **National Service Provider**
  - The following items are part of the equipment delivery:
    - Fisher 1704 Glass Filler Valve with Short Squeeze Lever & Fisher-Hose Food-Grade 60" (Model; 2915-FG)
    - The beverage vendor should be provided with this equipment upon their arrival at the store
    - nstructions here: Beverage National Curtis Install Instructions.pdf
- **Both Tea Brewers** will be receiving a **fabricated spigot holder** to mount on the Tea Brewer Table. Instructions are included in the individual install instructions

- Verify the integrity and connection of all lines for leaks. It is recommended to have shut-off valves for all new water lines

➢ Technology - If opting for an additional beverage monitor, validate placement of all necessary components (according to KES layouts on pages 35-38)
  - Monitor(s)
  - Controller(s)
  - Printer(s)
  - Bump Bar(s)
  - Applicable wires and brackets

➢ Reorganize Existing Equipment (according to KES layouts on pages 35-38)
  - Coffee brewers
  - OJ machine (if needed)
  - POS Stations
  - Creamer
  - Sugar Dispenser
  - Printer + Bump bar
  - Monitor(s)
  - Lid holder

**Note: Having a cash drawer at the DT present window area is not an approved operational standard. If you have a cash drawer on your DT cabinet, you will need to remove or relocate it to re-sequence your coffee equipment and create space for the beverage refresher station.*

➢ Equipment Install, Assembly, and Verification
  - POS Mounting Arm Installation
    - **Why add POS Mounting Arms:** Within CBB layouts, we've found benefits to having the POS elevated in the beverage area. This is being required to help optimize crew workflow and improve overall beverage cell efficiency
    - Your GC will be responsible for installing the pole mount and arm. An OTP Pro will be required to relocate the POS system. Detailed instructions are currently being developed and will be distributed as soon as they become available.
    - If your POS register 14 or 15 is one of the below 3 models, additional mounting considerations are required. Please work with your OTP Pro/Elite and/or POS Vendor directly for proper installation and deployment to ensure readiness:
      - PAR WAVE (requires additional PAR bracket. Please reach out to inform your PAR supplier for the need of a K6151B)
      - PAR ES650 (requires additional PAR bracket. Please reach out to inform your PAR supplier for the need of a K6151B)
      - NCR CX7 (this is a not a mountable POS system and will require a swap with a mountable POS register. Please work with your OTP Pro/Elite or POS vendor on applicable solutions)
  - New Refresher Printer + Bump Bar Holder on Creamer (if installing new beverage monitor)
    - Relocate Printer and Bump Bar to the new Holder
  - Refresher Station (Riser – if needed, Syrup Rail, Inclusion Holder, Refresher Pump Riser)

- Refresher Lid Holder
- New Base Refrigerator (if required)
- ABS Re-program

Parallel CBB Cell Technology Overview

*All tech installations are intended to be managed and installed by **OTP Pros or Elite**. If unavailable, this will require a Professional install.*

Due to these restaurants varying in layout and equipment needs, please refer to the store standards (reference pg. 36-39) to determine if your store will require new technology hardware.

❖ **Owner/Operator Responsibilities:**
- ➢ Owner/Operator to review the playbook thoroughly and understand the criteria outline for determining whether to purchase an additional dedicated beverage monitor
- ➢ Coordinate completion of all pre-electrical work if selecting to install new hardware
- ➢ Ensure that a qualified individual within the organization is responsible for reaching out to POS Vendor and ordering any required technology hardware and coordinating the installation process (e.g. with POS Vendor or OTP Pro or Elite)
- ➢ Place an order with POS Vendor for any necessary technology hardware to support the National Beverage rollout

❖ **POS Vendor Responsibilities:**
- ➢ Provide a quote for new technology hardware upon request from the O/O
- ➢ Ship necessary technology hardware to store(s)
- ➢ Schedule the installation of new technology hardware, if the Owner/Operator has opted for professional installation

❖ **OTP Pro or Elite Responsibilities** (if owner/operator has opted for OTP installation)
- ➢ Complete the initiative-specific OTP Pro training (link to final training when complete)
- ➢ Install & configure all new beverage-specific technology hardware

Parallel CBB Cell Required Equipment

Due to these restaurants varying in layout and equipment needs, please refer to your equipment order from your KES.

Other Restaurants (In-Store/Non-DT, Oil-Alliance, Walmart)

Equipment Installation

All installations are intended to be managed and installed by the owner/operator.

- **Owner/Operator Responsibilities:**
  - Familiarize yourself with the contents of the playbook
  - Identify the restaurant layout
  - Complete the KES online equipment order guide
  - Approve your equipment order by the equipment ordering deadline
  - Verify and obtain all required permitting and inspection requirements
  - Coordinate the completion of all utility work and the installation of your beverage equipment

- **KES Responsibilities:**
  - Send out the Online Order Guide
  - Manufacture, consolidate, and ship equipment to support the O/O's installation

- **Installation Requirements**
  - Remove BBR and make wall repairs (if necessary)
    - **Why you may need to remove your BBR**: If the BBR is located over DT cabinet and equipment can't be re-sequenced to fit underneath the BBR, you will need to remove it to accommodate the new beverage equipment.
    - If BBR is removed, the product that is currently being stored there will need to be relocated to another refrigerator that is near the DT assembly or present area to minimize the additional steps for the crew. Please review the entire service area in your restaurant to determine the correct location to relocate these products.
  - Electrical Work
    - Schedule with local licensed Electrical Contractor (EC) and/or McD-approved General Contractor (GC) to coordinate with OO and OTP resource to:
      - Verify/relocate the location of isolated ground power outlets for any new technology that will be installed
      - Add/Relocate (or identify) the location of power for Relocated:
        - Base Refrigerator
        - Sugar Dispenser
        - OJ
        - Creamer
      - Summary of available outlets needed at completion:
        - Base Refrigerator (1- verify/add/relo/reuse)
        - Equipment (3- verify/add/relo/reuse)
  - Beverage Water Pre Work
    - **Note:** Water installation for this program includes a T-off from the chilled water line at the tea brewer and installing a Fisher Filler valve kit to dispense chilled water.
      - For restaurants without a multiplex: To ensure dispensed water meets the required temperature range of 36-40 F, restaurants will need an appropriate equipment solution. For guidance on equipment placement and available options, please contact your assigned KES representative.

- **IMPORTANT**: The Tea Brewer will require a retrofit on the dilution line to be able to produce water to a Fisher Filler Valve to create beverage bases
- **If you have a BUNN Tea Brewer**, you will receive a **"self-install" kit** to be assembled with the Fisher Filler Valve kit
  - Self-Install Kit (Part# KIT-FISHER10003) & Fisher Filler Kit (Model# 2915-FG)
  - This is intended to remove a Beverage Service Technician visit and allow the restaurant to execute in-house
  - **Please utilize instructions here:** Beverage National BUNN Self Install Instructions.pdf
- **If you have a Curtis Tea Brewer**, you will be receiving **a service visit** from a **National Service Provider**
  - The following items are part of the equipment delivery:
    - Fisher 1704 Glass Filler Valve with Short Squeeze Lever & Fisher-Hose Food-Grade 60" (Model; 2915-FG)
    - The beverage vendor should be provided with this equipment upon their arrival at the store
    - Please review instructions here: Beverage National Curtis Install Instructions.pdf
- **Both Tea Brewers** will be receiving a **fabricated spigot holder** to mount on the Tea Brewer Table. Instructions are included in the individual install instructions
- If OJ needs to be relocated, the existing chilled water line length needs to be verified to accommodate the new location
  - Relocation of the existing line or a new chilled water line to a new location may be needed
  - **The restaurant is responsible for completing in-house or scheduling service for this**
- Verify the integrity and connection of all lines for leaks. It is recommended to have shut-off valves for all new water lines

➢ Technology – reference the KES layouts on pages 39-54 to determine if you will be required to add a dedicated beverage monitor and supporting components:
- Monitor(s)
- Controller(s)
- Printer(s)
- Bump Bar(s)
- Applicable wires and brackets

➢ Reorganize Existing Equipment (according to KES layouts on pages 39-54)
- Creamer
- OJ
- Lids
- Iced Bev
- Syrup
- Printer Shelf, Printer + Bump Bar
- Sugar Dispenser
- Lid Holder

- Refrigerator Table
- Base Refrigerator
- Tea Stand
- POS
- Iced Beverage

**Note: Having a cash drawer at the DT present window area is not an approved operational standard. If you have a cash drawer on your DT cabinet, you will need to remove or relocate it to re-sequence your coffee equipment and create space for the beverage refresher station.*

- Equipment Install, Assembly, and Verification
  - Refresher Station (Riser – if needed, Syrup Rail, Inclusion Holder, Refresher Pump Riser)
  - Refresher Lid Holder
  - ABS Re-program

Other Layouts Required Equipment

Due to these restaurants varying in layout and equipment needs, please refer to your equipment order from your KES.

Technology Overview

*All tech installations are intended to be managed and installed by **OTP Pros or Elite**. If unavailable, this will require a Professional install.*

Due to the various layouts and equipment needs of these restaurants, please refer to the store standards (pages 39-54) to determine if your store will require new technology hardware.

- **Owner/Operator Responsibilities:**
  - Owner/Operator to review the playbook thoroughly and understand the criteria outline for determining whether to purchase an additional dedicated beverage monitor
  - Coordinate the completion of all pre-electrical work if selecting to install new hardware
  - Ensure that a qualified individual within the organization is responsible for reaching out to POS Vendor and ordering any required technology hardware and coordinating the installation process (e.g. with the POS Vendor or OTP Pro or Elite)
  - Place an order with the POS Vendor for any necessary technology hardware to support the National Beverage rollout

- **POS Vendor Responsibilities:**
  - Provide a quote for new technology hardware upon request from the O/O
  - Ship necessary technology hardware to store(s)
  - Schedule install of new technology hardware, if the Owner/Operator has opted for professional installation

- **OTP Pro or Elite Responsibilities** (if owner/operator has opted for OTP installation)
  - Complete the initiative specific OTP Pro training (link to final training when complete)
  - Install & configure all new beverage-specific technology hardware

Equipment Readiness Checklist

CBB Checklist

Beverage Equipment Readiness Checklist	
Layout: CBB	
Complete Equipment Survey & Tech Assessment **Check when complete**	
O/O & Mid Manager responsibility	☑
Review recorded overview of the equipment survey.	
Review the Equipment Playbook to understand the equipment survey and determine which layout applies to your restaurant.	
Prep for Equipment Survey & Order. Verify the following:	
o Countertop length of current DT cabinet	
o Does your existing DT cabinet have an ice bin?	
o Do you have an existing wall mount bottle beverage refrigerator above the DT cabinet?	
o Do you have a dedicated OJ/POS table in your CBB cell? Is there a reach-in refrigerator underneath that OJ/POS table?	
Review equipment playbook to determine if you will be purhcasing an additional beverage monitor	
Attend Office Hours if needed	
Complete the equipment survey and submit equipment order by due date.	
Prep: Prior to Equipment Delivery & Tech Deployment **Check when complete**	
O/O & Mid Manager responsibility	☑
Ensure there is somebody in the organization responsible for equipment and technology deployment	
Review the Equipment Playbook and determine correct equipment layout for restaurant	
Remove Bottled Beverage Refrigerator and repair wall (if over DT cabinet and not enough space to relocate equipment per layouts)	
Verify/relocate power for: Monitors (1 Merge, 2 Order), Bump bar + printer, Sugar dispenser, POS (2), Creamer, OJ, GemX Narrow Brewer (if needed)	
Coordinate with Electrical Contractor/General Contractor for new equipment requiring electrical:	
o Determine if permitting is needed	
o Power for new printer - Twist IG power outlets for POS devices (if purchasing dedicated beverage monitor)	
o Data wire and boxes for printer and bump bar (if purchasing dedicated beverage monitor)	
o Power for reach-in refrigerator (if needed)	
o Additonal power (if needed from above)	
Kitchen Equipment Set Up and Install **Check when complete**	
O/O & Mid Manager responsibility	☑
Water pre-work:	
o If professional install: Provide beverage vendor with Glass Filler Valve, Food-Grade Hose. Vendor installs this equipment.	
o If self-install: use install instructions and install Glass Filler Valve, Food-Grade Hose.	
Reorganize: Coffee brewers, OJ, POS, Creamer, Sugar Dispenser, Printer, Monitor, Lid Holder (reference layouts in Equipment Playbook)	
o Tip: this is a good opportunity to implement cable management and roll-up water lines off the floor	
Install: Refresher Station (Riser Shelf – if needed, Syrup Rail, Inclusion Holder, Refresher Pump Riser, Lid Holder)	
Install: Register Mounting Arms	
Verify Small Wares Packages: refer to Equipment Playbook to ensure everything is included in the order	
Technology: **Check when complete**	
Vendor Install & O/O or Mid Manager follow up	☑
Hardware	
Determine the site needs (e.g. threaded rod, installing new tech hardware, etc.)	
Determine if Home Run in a Box ("HRIAB") is required for your store. If needed, please consolidate with other ceiling work.	
Confirm if permitting is necessary for any of your required tech prep	
Verify/relocate power for: Monitors (1 merge, 2 order), Controller, Bump Bar, Printer. ***Note:*** If installing a new monitor, 3 outlets will need to be available (KVS, Monitor, Printer). These electrical needs must be met before POS installer begins works	
Reach out to your preferred POS Supplier to obtain a quote for your hardware needs and sign as soon as possible to secure necessary inventory. ***Note: S*ome POS suppliers may opt to provide standard quotes vs. customized quotes	
Schedule installation for necessary tech hardware with POS Vendors. While the hardware is not required for go-live, the below dates are reccomendations to ensure readiness by start of the launch: Reach out to POS Vendor: by 12/1/2025 Order Hardware: by Fri. 1/9/2026 Delivery of Hardware: by 2/2/2026 All Installs Complete: by 3/27/2026 *note: you will receive additional information once a schedule has been finalized	
Ensure all newly installed tech hardware is powered on and visibily operational	
Verify the new Hardware is set up correctly via the updated Restaurant Builder push	

BDAP Checklist


Beverage Equipment Readiness Checklist Layout: BDAP	
Complete Equipment Survey & Tech Assessment — **Check when complete**	
O/O & Mid Manager responsibility	✓
Review recorded overview of the equipment survey.	
Review the Equipment Playbook to understand the equipment survey and determine which layout applies to your restaurant.	
Prep for Equipment Survey & Order. Verify the following:	
o Can you create 37" of available space on the countertop to accommodate the new refresher station. This refresher station must be adjacent to your existing refrigeration	
o What type of refrigeration is located near where the refresher station will go (2-drawer or reach-in cooler)?	
Review equipment playbook to determine if you will be purhcasing an additional beverage monitor	
Attend Office Hours if needed	
Complete the equipment survey and submit equipment order by due date	
Prep: Prior to Equipment Delivery & Tech Deployment — **Check when complete**	
O/O & Mid Manager responsibility	✓
Review the Equipment Playbook and determine correct equipment layout for restaurant	
Verify/relocate power for: Monitors (1 Merge, 2 Order), Bump bar + printer (if needed per above), Sugar dispenser, POS (2), Creamer,	
Coordinate with Electrical Contractor/General Contractor for new equipment requiring electrical:	
o Determine if permitting is needed	
o Power for new printer - Twist IG power outlets for POS devices (if purchasing dedicated beverage monitor)	
o Data wire and boxes for printer and bump bar (if purchasing dedicated beverage monitor)	
o Power for reach-in refrigerator (if needed)	
Ensure your OTP has completed training for the technology requirements/deployment	
Kitchen Equipment Set Up and Install — **Check when complete**	
O/O & Mid Manager responsibility	✓
Water pre-work:	
o If professional install: Provide beverage vendor with Glass Filler Valve, Food-Grade Hose. Vendor installs this equipment.	
o If self-install: use install instructions and install Glass Filler Valve, Food-Grade Hose.	
Reorganize: Coffee brewers, OJ, POS, Creamer, Sugar Dispenser, Printer, Monitor, Lid Holder	
o Tip: this is a good opportunity to implement cable management and roll-up water lines off the floor	
Install: Refresher Station (Syrup Rail, Inclusion Holder, Refresher Pump Riser, Lid Holder)	
Install: new printer/bump bar bracket (if needed). Relocate printer/bump bar to this location per layout	
Verify Small Wares Packages: refer to Equipment Playbook to ensure everything is included in the order	
Technology: — **Check when complete**	
Vendor Install & O/O or Mid Manager follow up	✓
Hardware	
Determine the site needs (e.g. threaded rod, reusing existing hardware, etc.)	
Determine if Home Run in a Box ("HRIAB") is required for your store. If needed, please consolidate with other ceiling work.	
Confirm if permitting is necessary for any of your required tech prep	
Verify/relocate power for: Monitors (1 merge, 2 order), Controller, Bump Bar, Printer. ***Note:*** If installing a new monitor, 3 outlets will need to be available (KVS, Monitor, Printer). These electrical needs must be met before POS installer begins works	
Reach out to your preferred POS Supplier to obtain a quote for your hardware needs and sign as soon as possible to secure necessary inventory. ***Note: S*** **om**e POS suppliers may opt to provide standard quotes vs. customized quotes	
Schedule installation for necessary tech hardware with POS Vendors. While the hardware is not required for go-live, the below dates are reccomendations to ensure readiness by start of the launch: Reach out to POS Vendor: by 12/1/2025 Order Hardware: by Fri. 1/9/2026 Delivery of Hardware: by 2/2/2026 All Installs Complete: by 3/27/2026 *note: you will receive additional information once a schedule has been finalized	
Confirm devices are on and operational	
Verify the new Hardware is set up correctly via the updated Restaurant Builder push	

Detailed Plans/Layouts


Blue = new
Red = existing
Green = optional

CBB Layouts

Beverage Integration CBB Layout A – 2nd Side ABS on 62.75" Cabinet

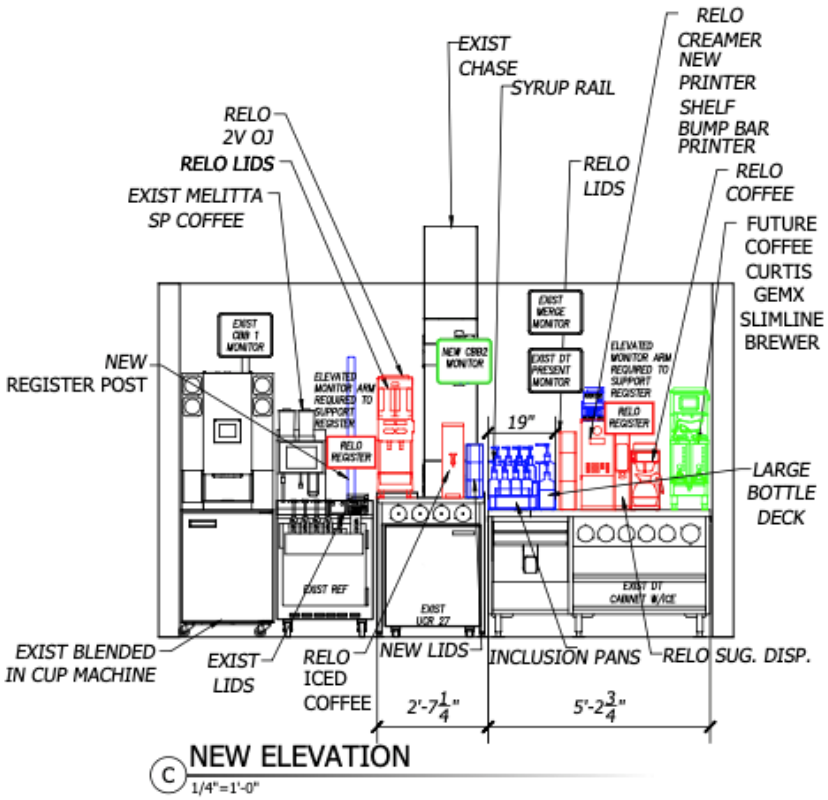


C NEW ELEVATION
1/4"=1'-0"

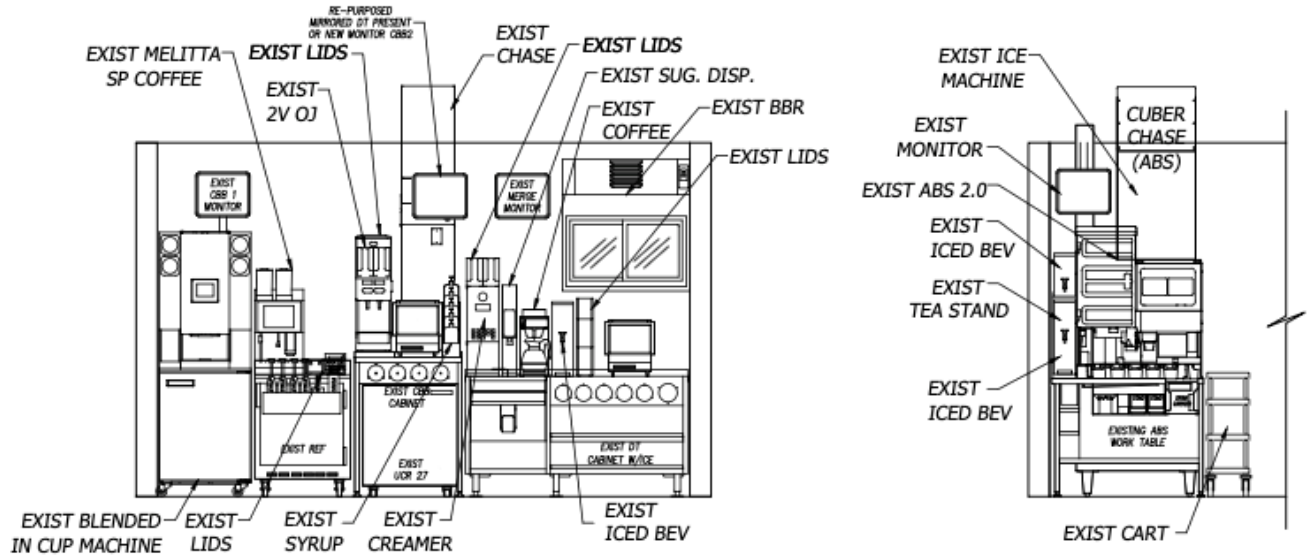


A EXISTING ELEVATION
1/4"=1'-0"

Beverage Integration CBB Layout B – 2 Decanter Brewers, 1 Decanter Warmer on 62.75” Cabinet

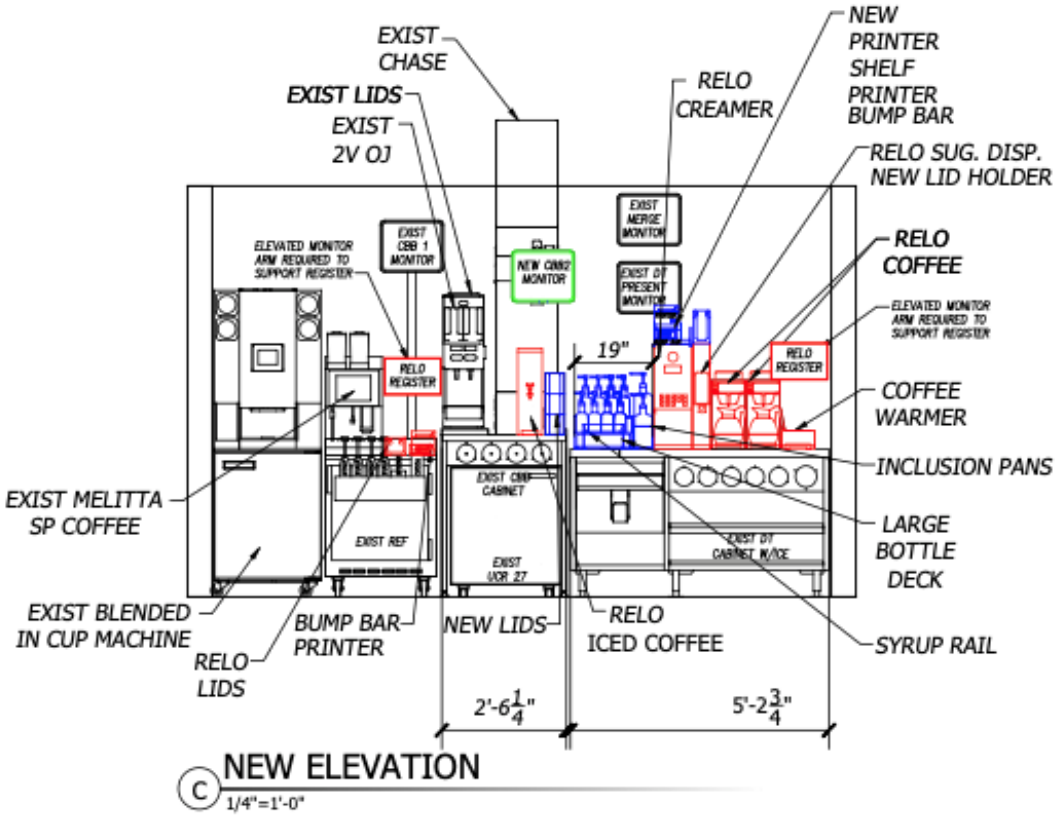


C NEW ELEVATION
1/4"=1'-0"

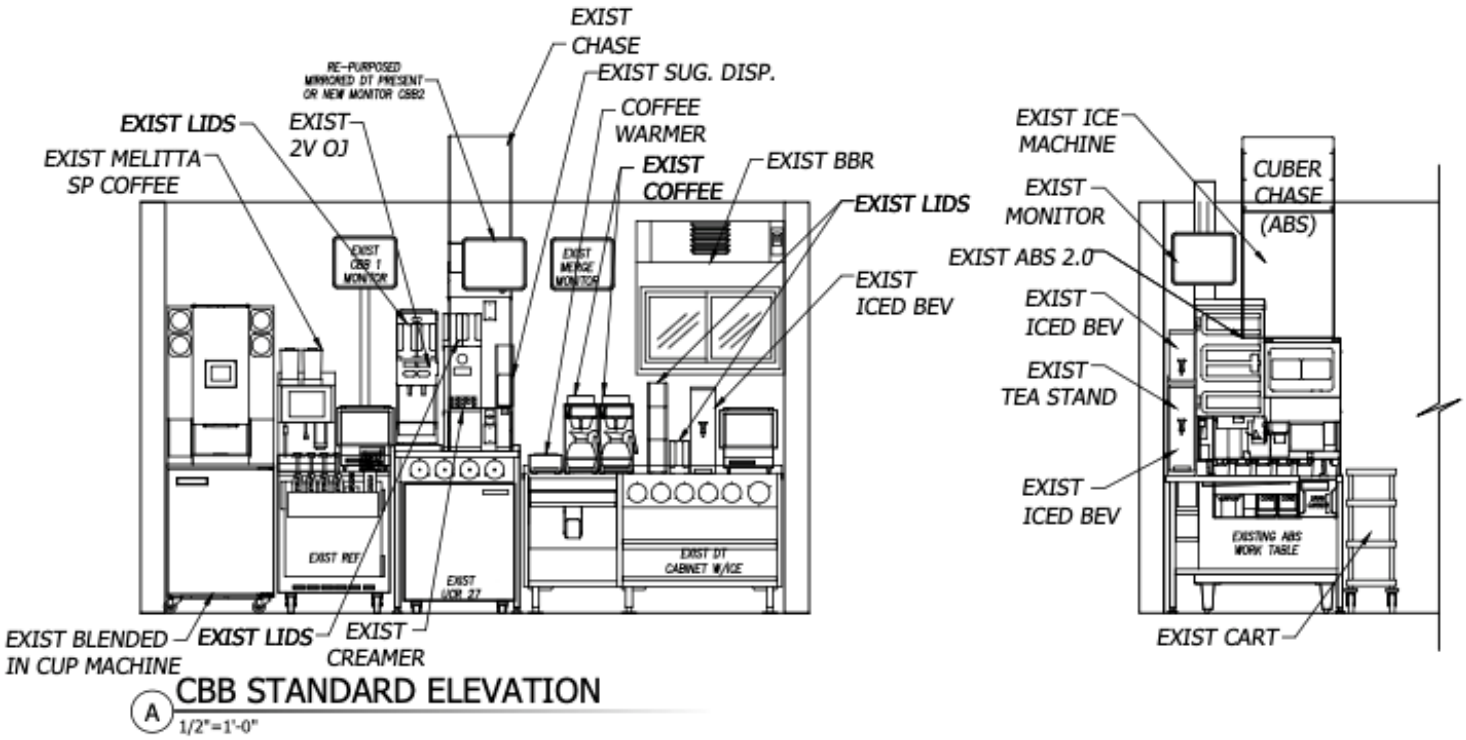


A CBB STANDARD ELEVATION
1/2"=1'-0"


Beverage Integration CBB Layout C – 1 Satellite Brewer & Warmer, 1 Decanter Warmer on 62.75” Cabinet

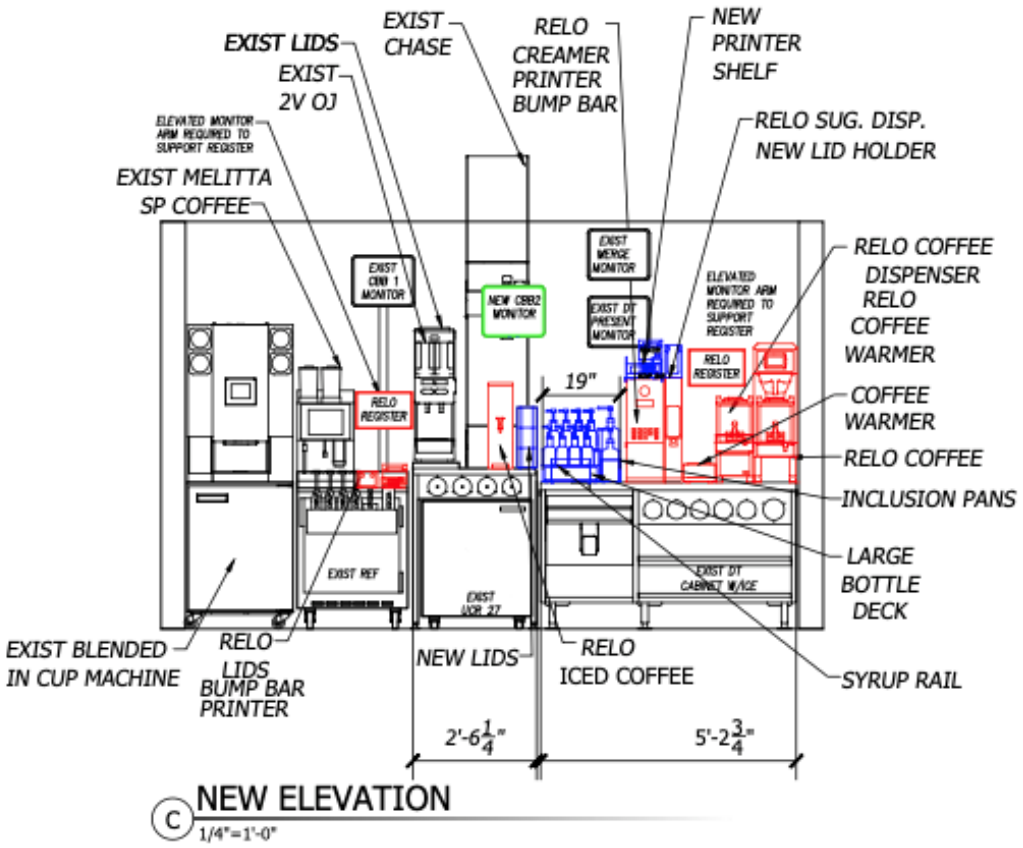


C NEW ELEVATION
1/4"=1'-0"

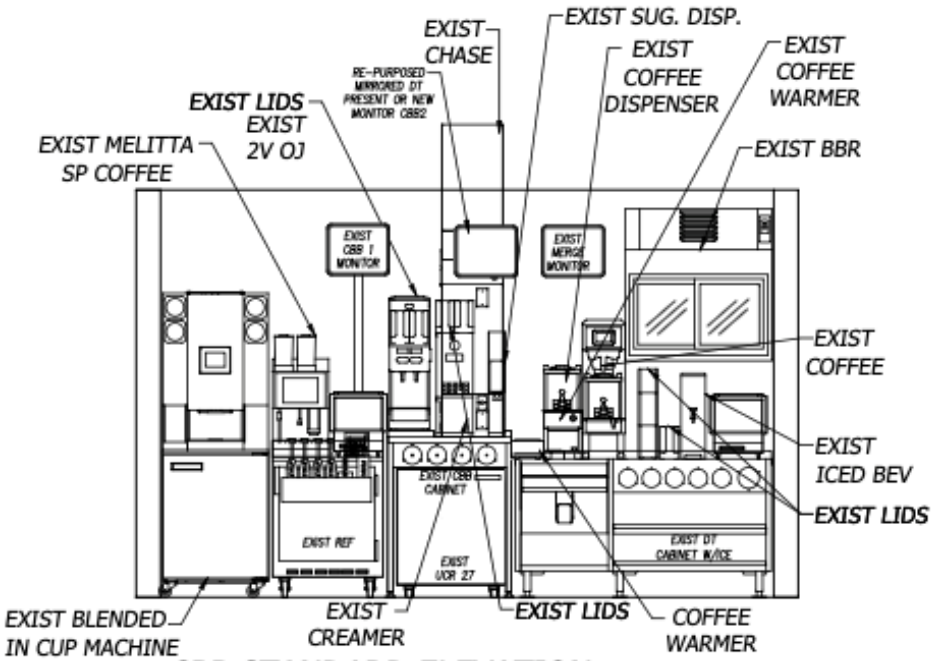


A CBB STANDARD ELEVATION
1/2"=1'-0"

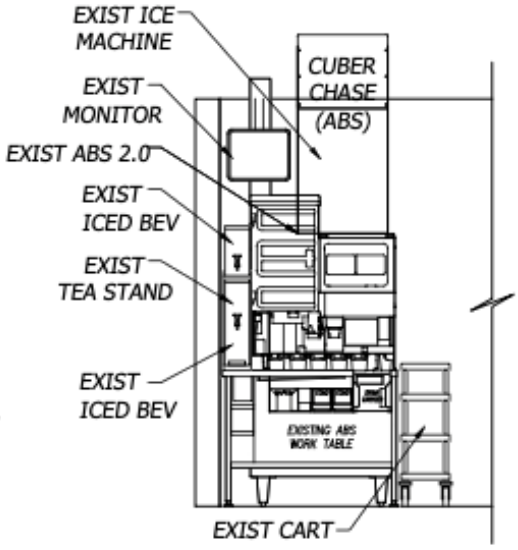

Beverage Integration CBB Layout D – Same Side ABS on 58” Cabinet

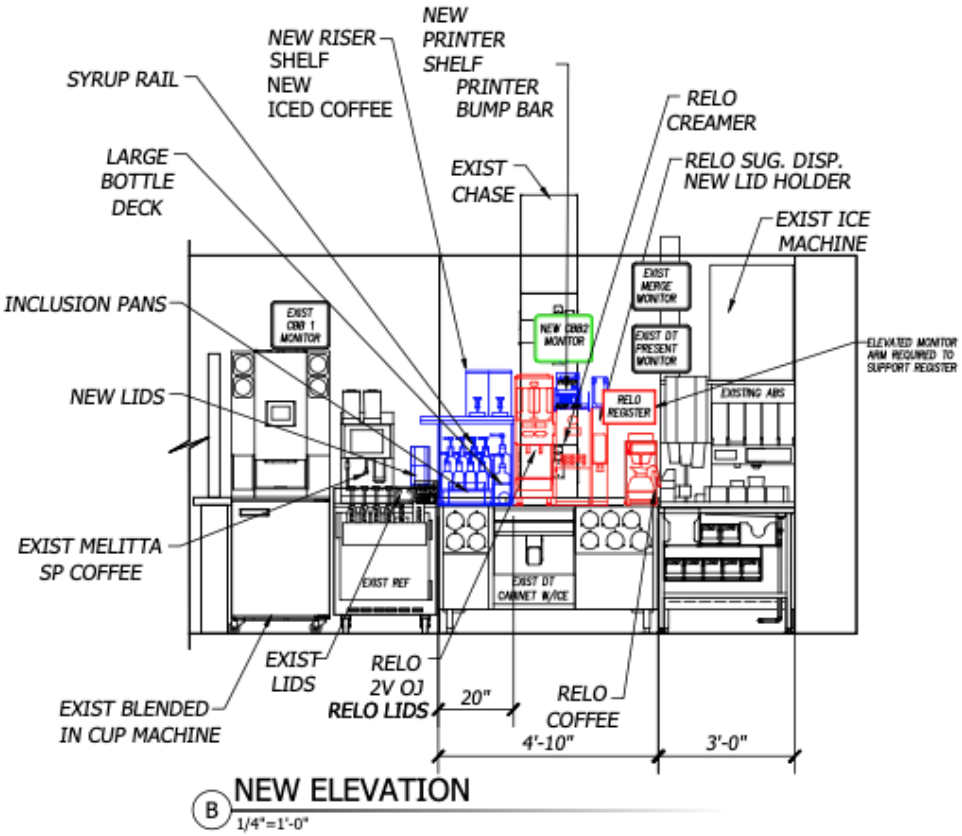


B NEW ELEVATION
1/4"=1'-0"

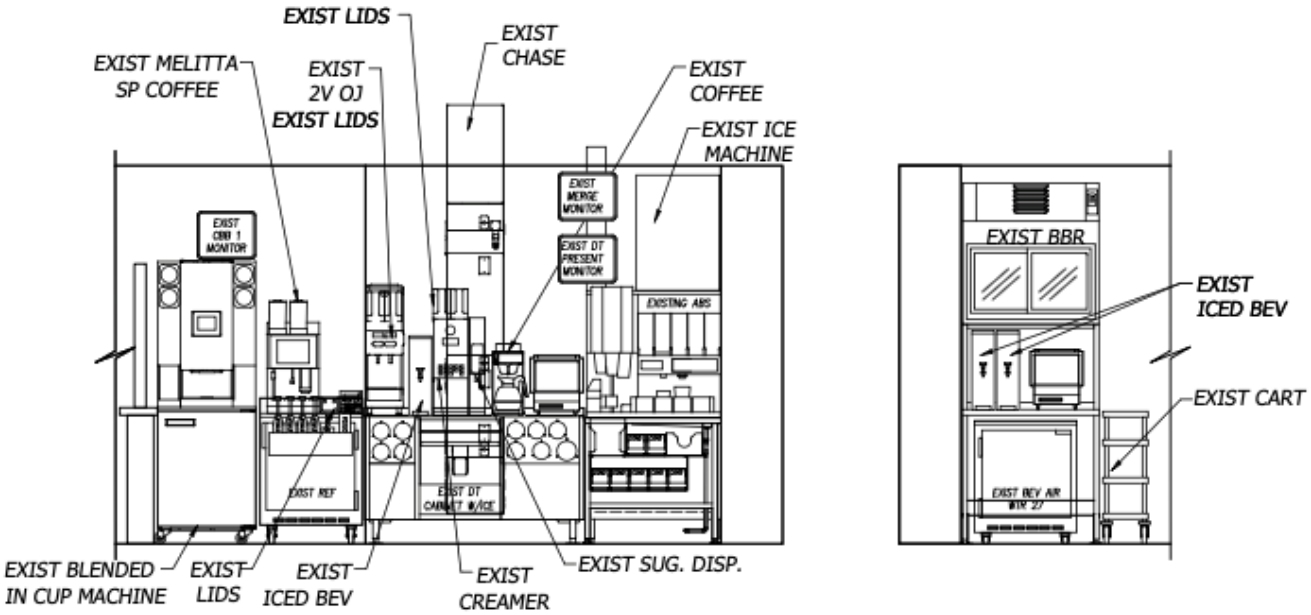


C DRIVE THRU ELEVATION
1/4"=1'0"


BDAP Layouts


Beverage Integration BDAP Exterior Wall Layout A – New Restaurant Standard

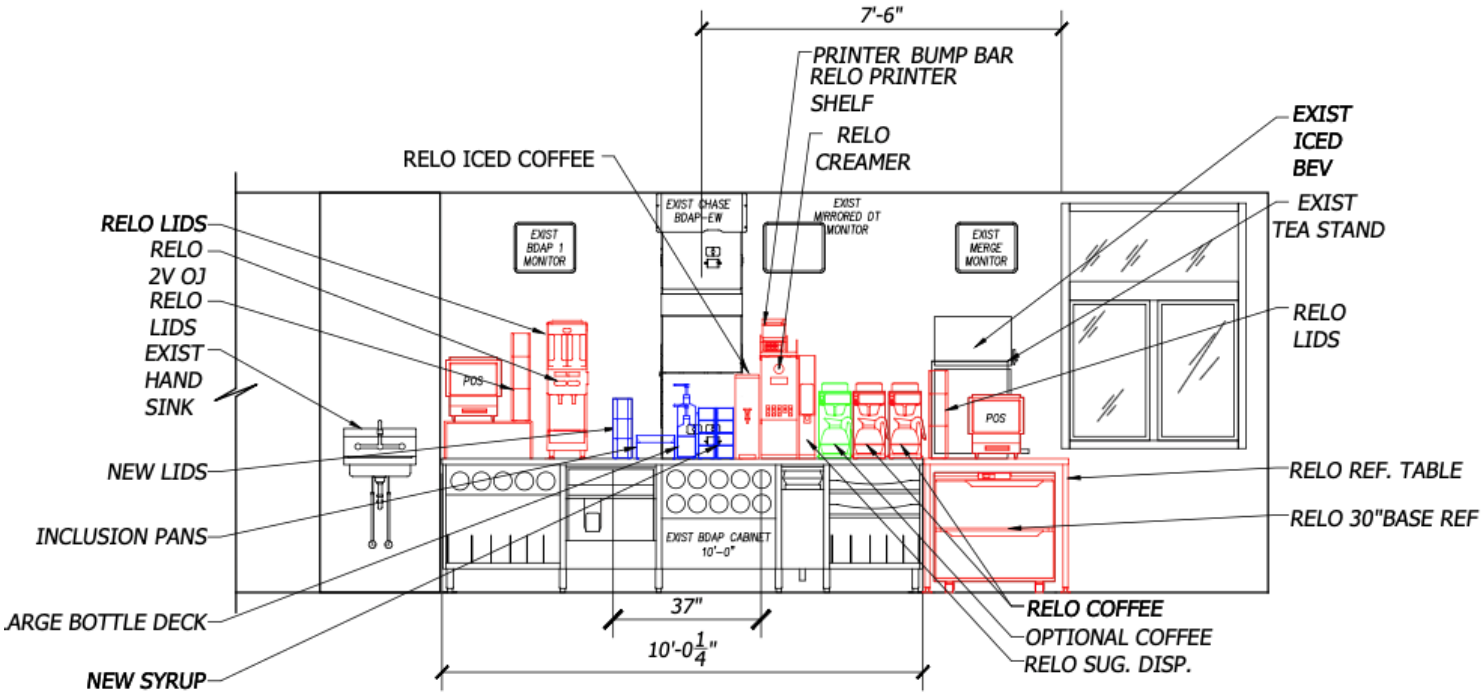

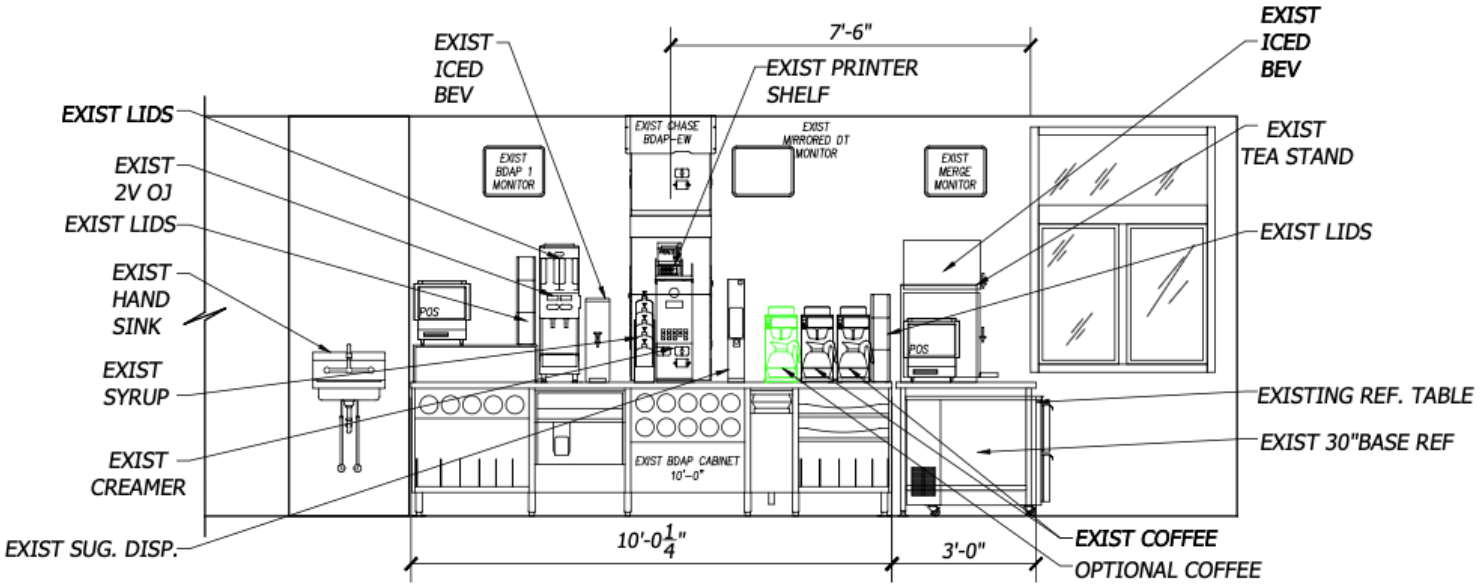



Beverage Integration BDAP Exterior Wall Layout B – With 13' Cabinet

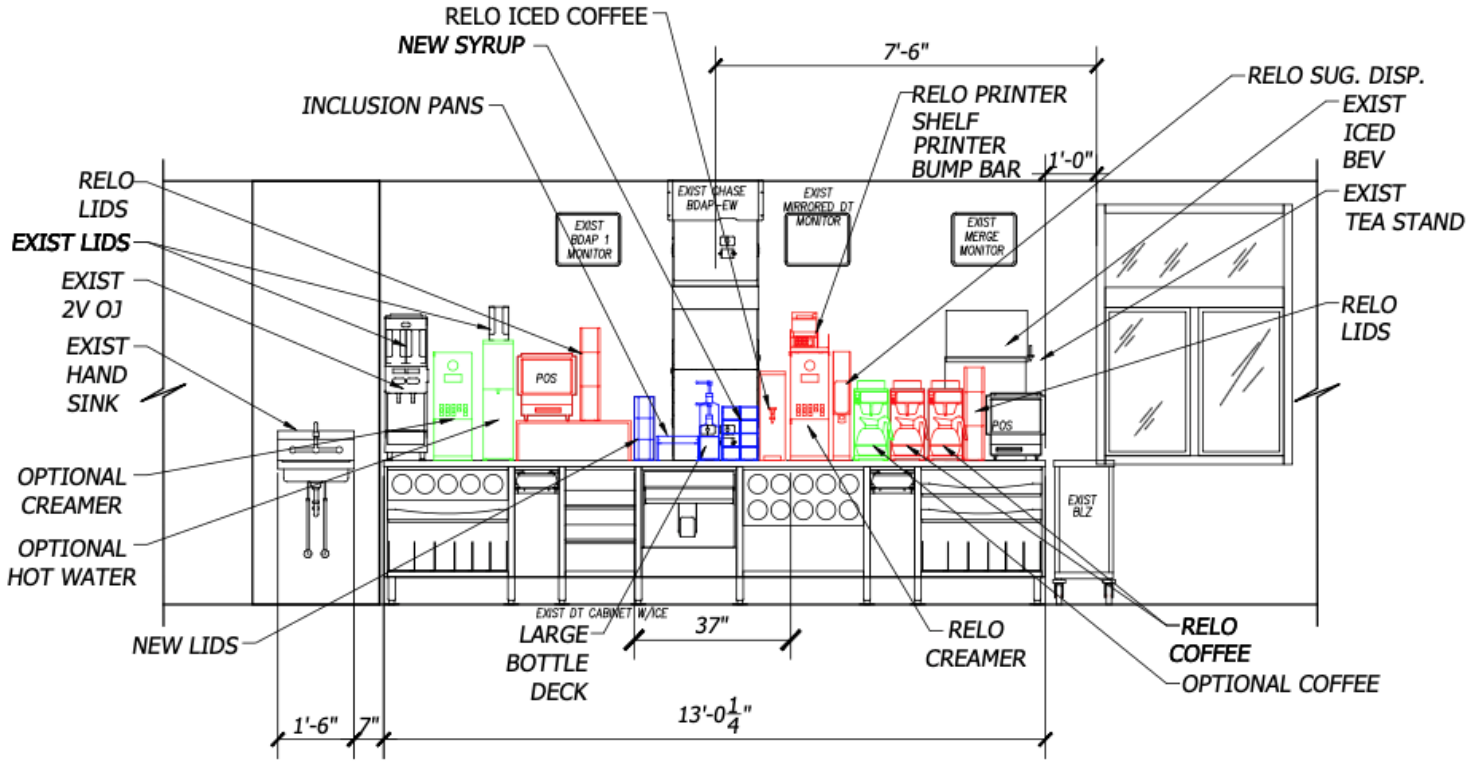

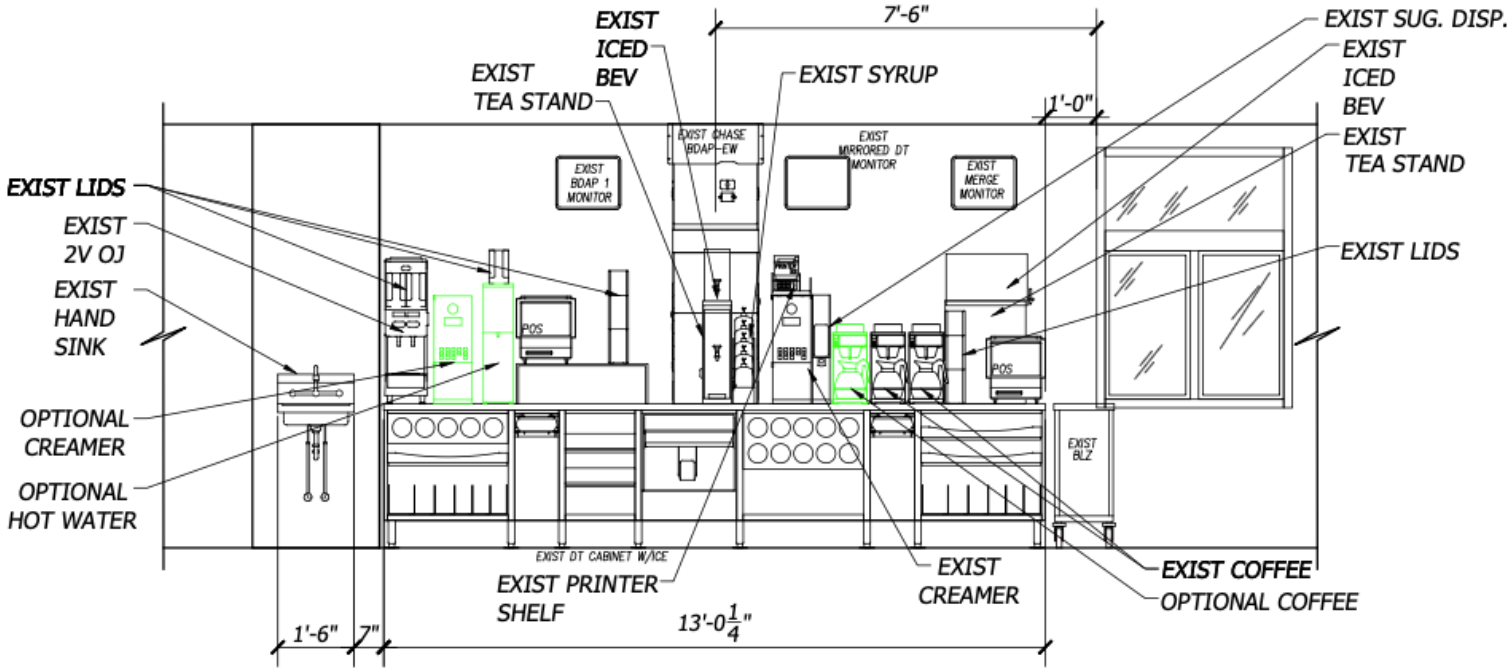


Beverage Integration BDAP Exterior Wall Layout C – With 10' Cabinet

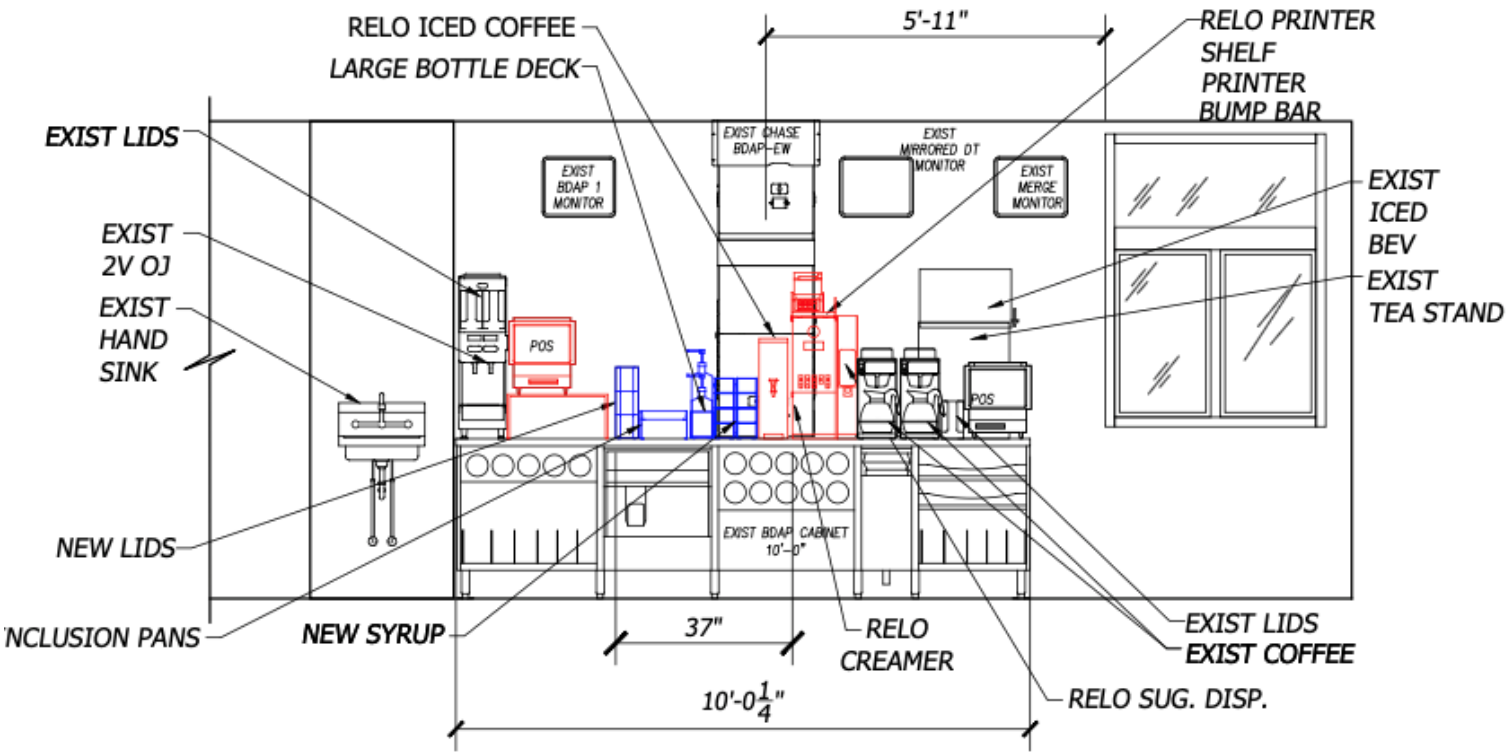


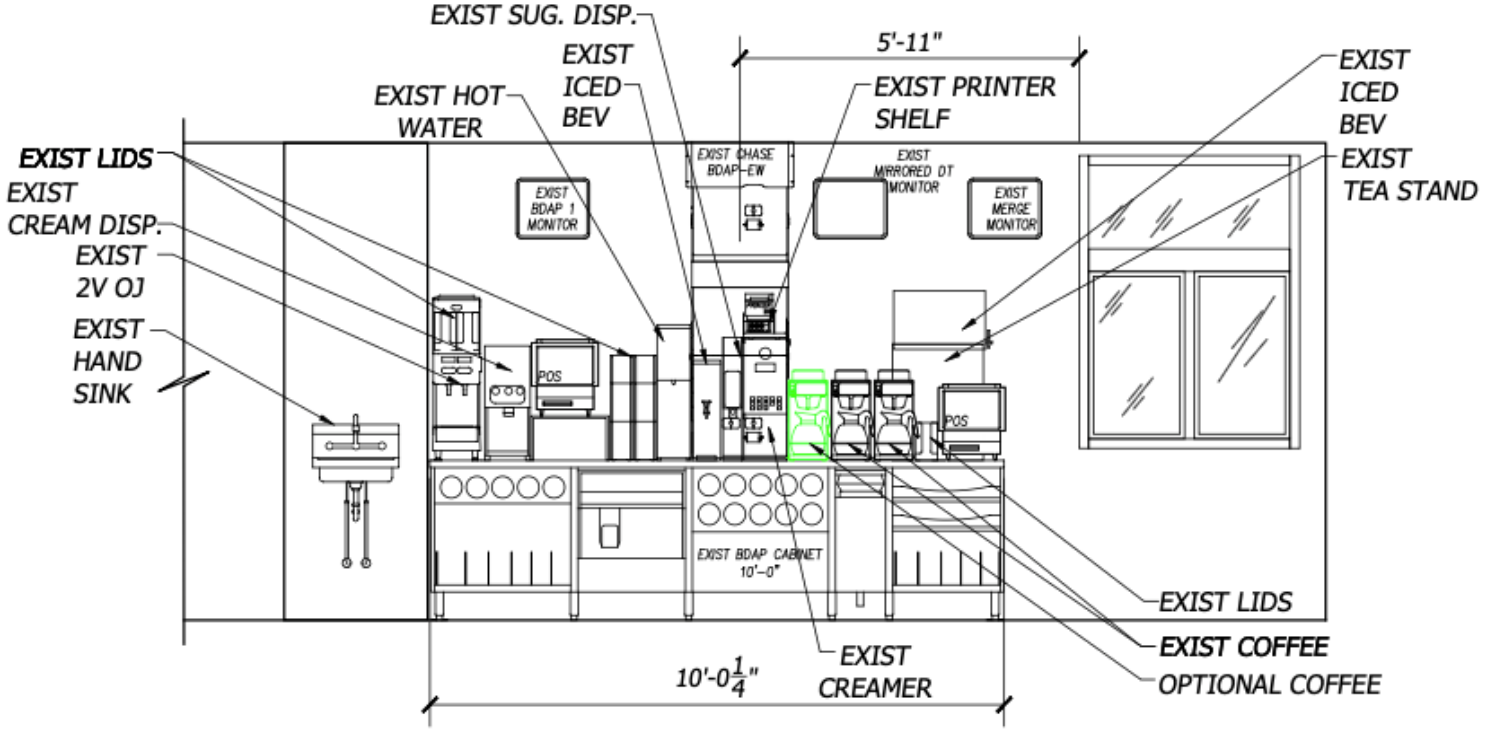


Parallel CBB Layouts


Beverage Integration Parallel CBB Cell Exterior Wall Layout A

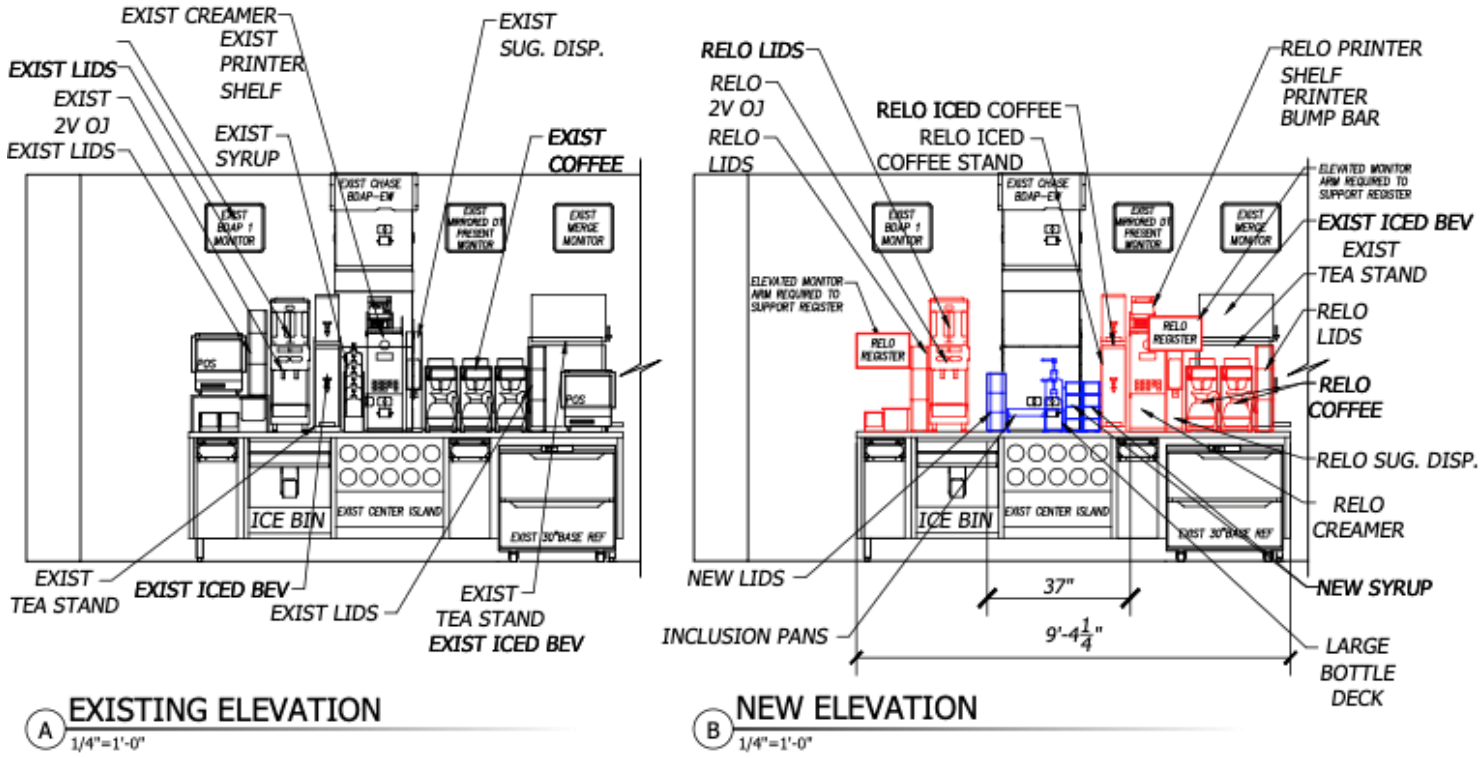

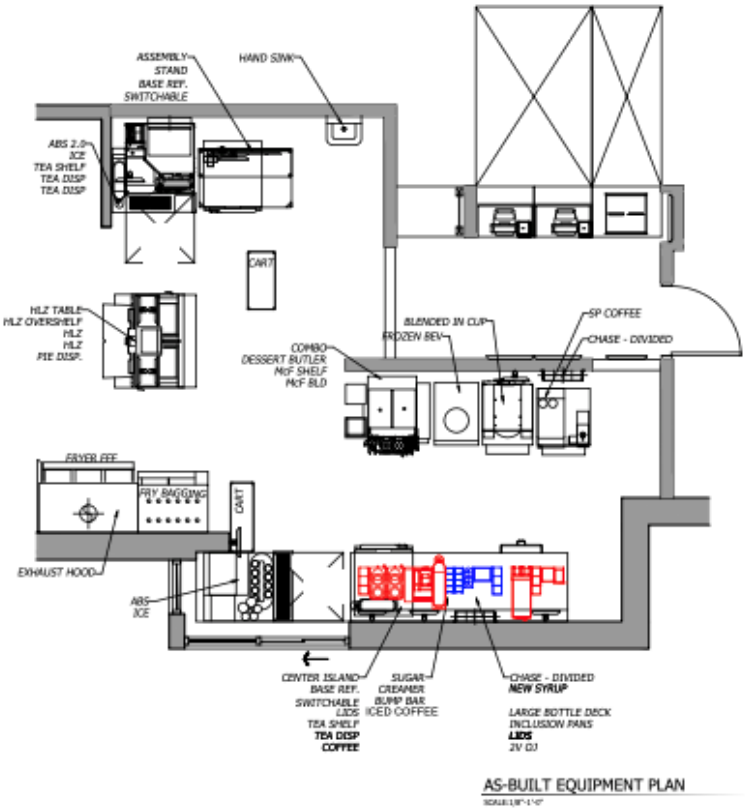


Beverage Integration Parallel CBB Cell Exterior Wall Layout B

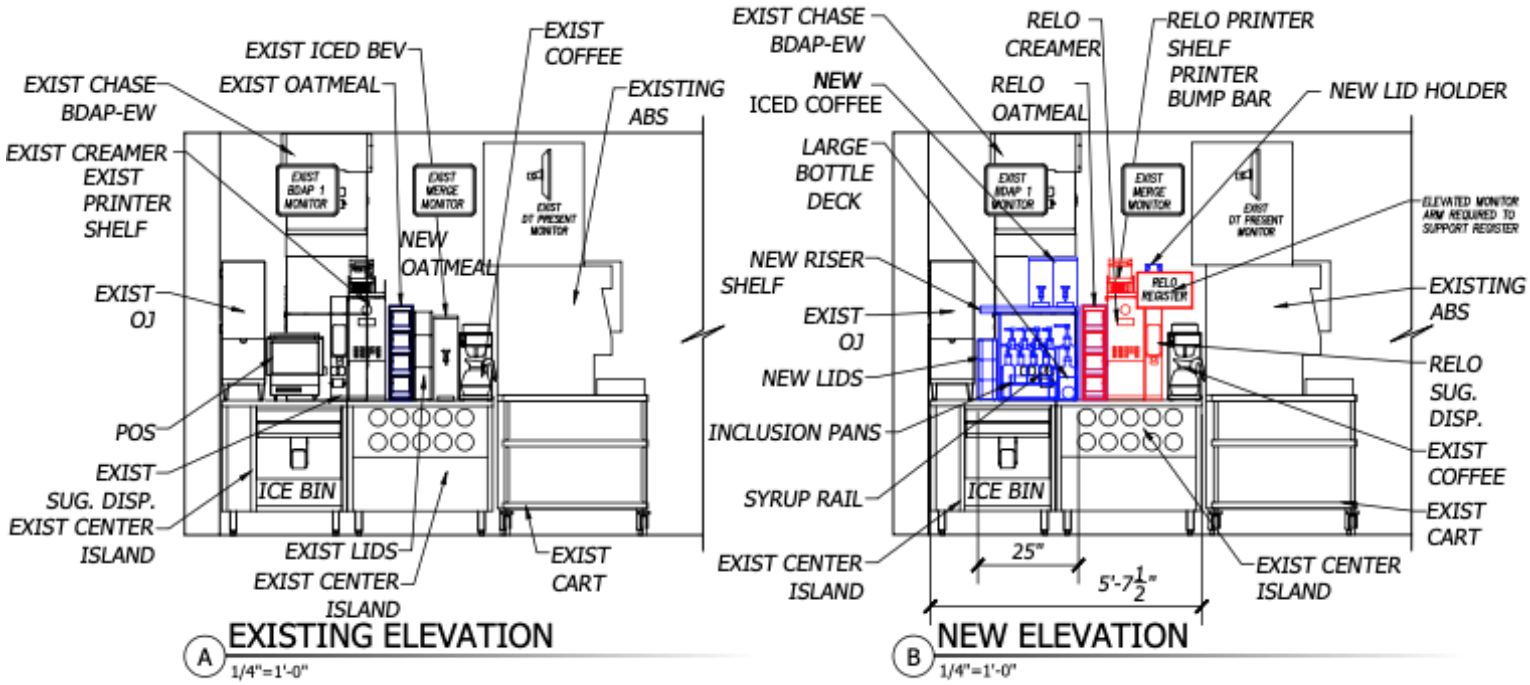


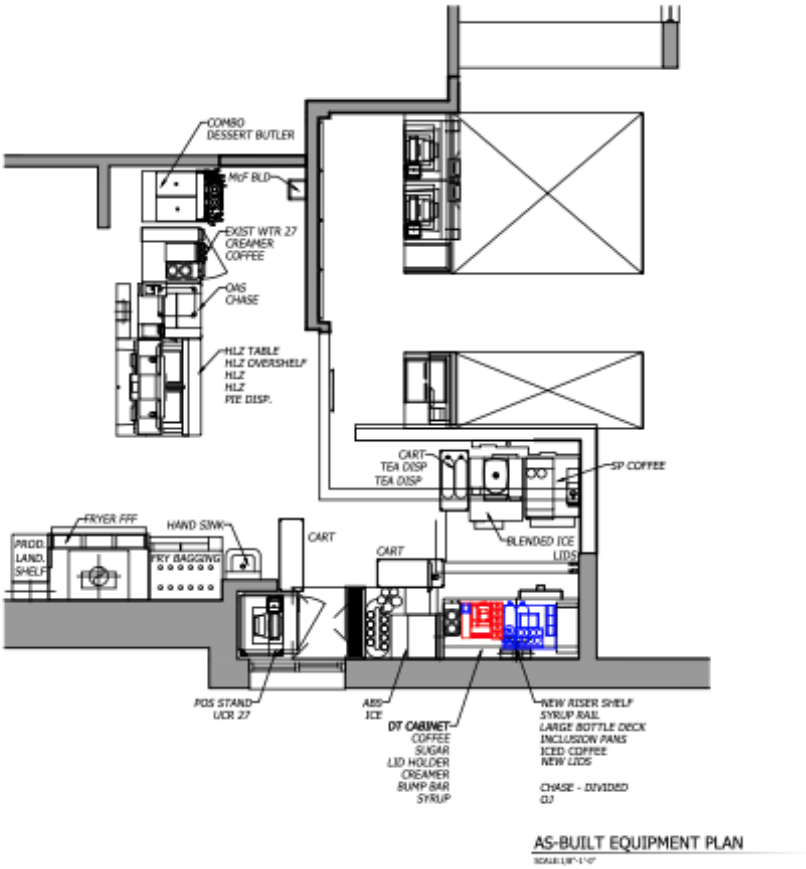


Beverage Integration Parallel CBB Cell Exterior Wall Layout C

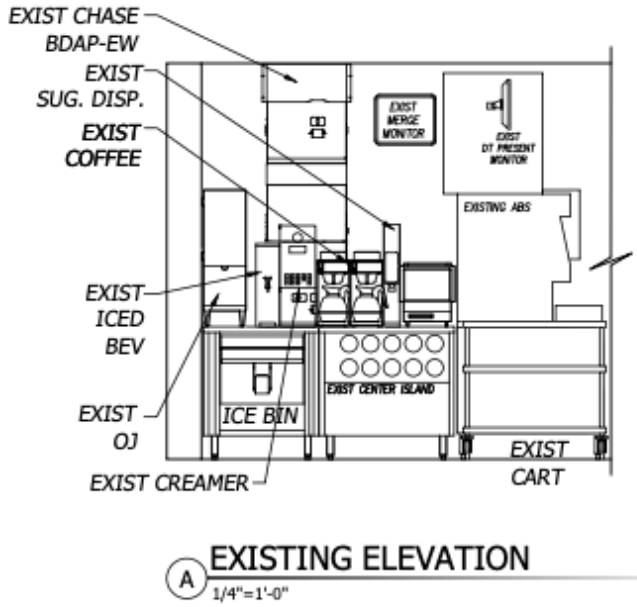

A EXISTING ELEVATION
1/4"=1'-0"

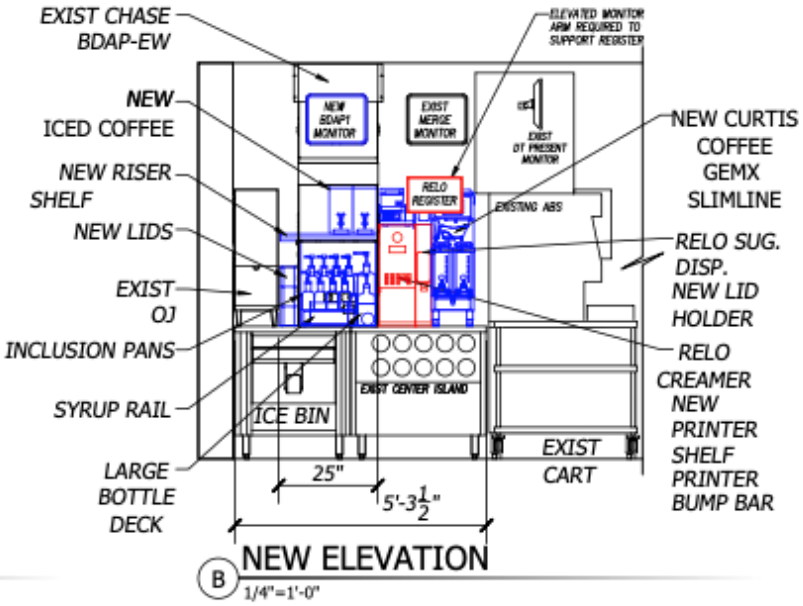



B NEW ELEVATION
1/4"=1'-0"

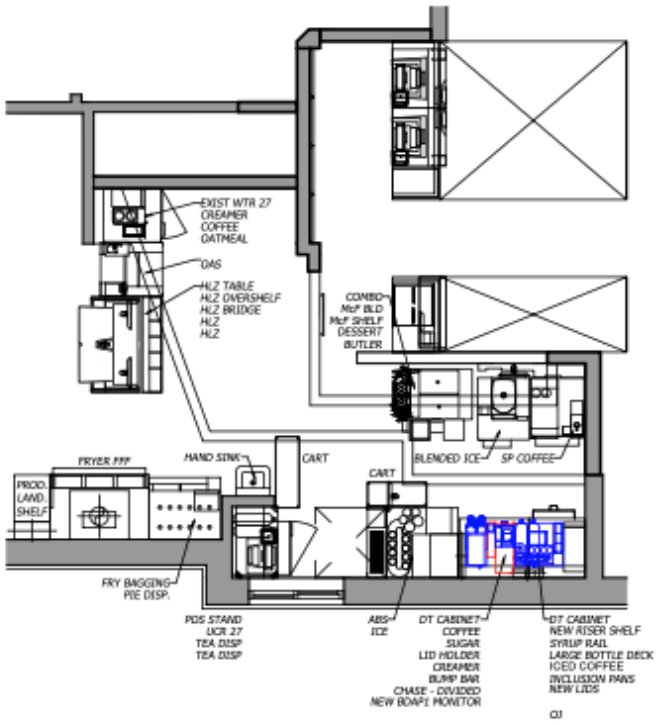

AS-BUILT EQUIPMENT PLAN


Beverage Integration Parallel CBB Cell Exterior Wall Layout D

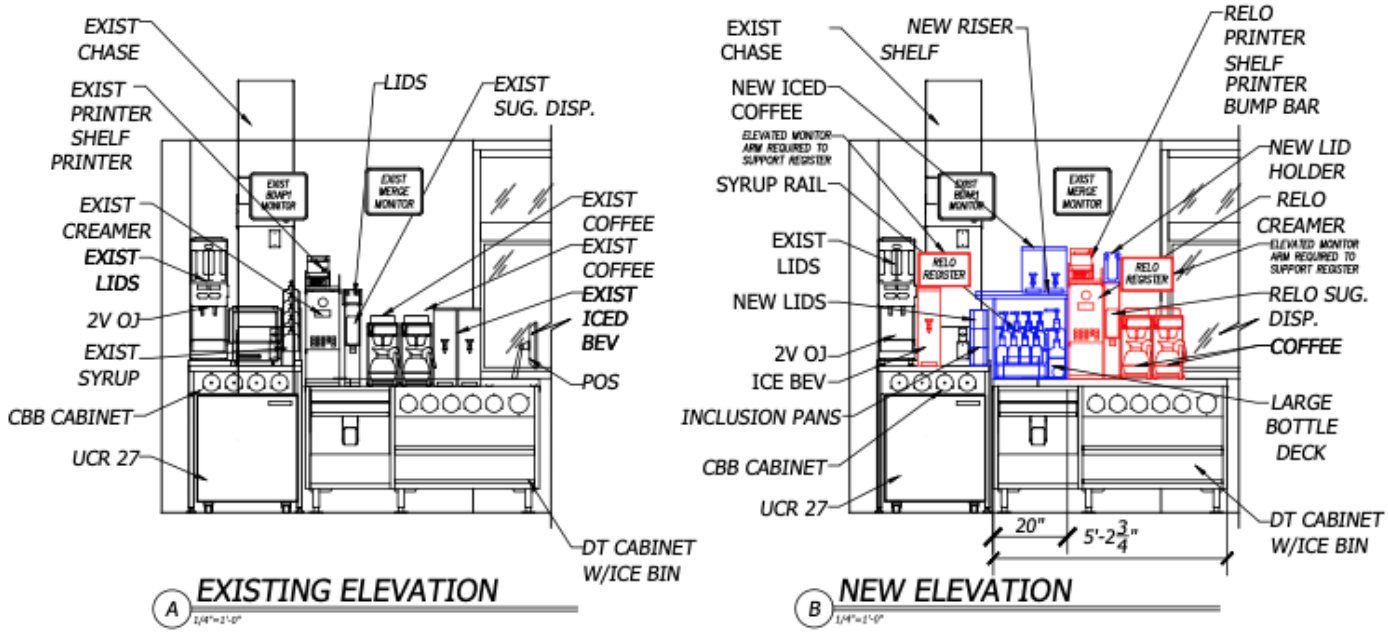


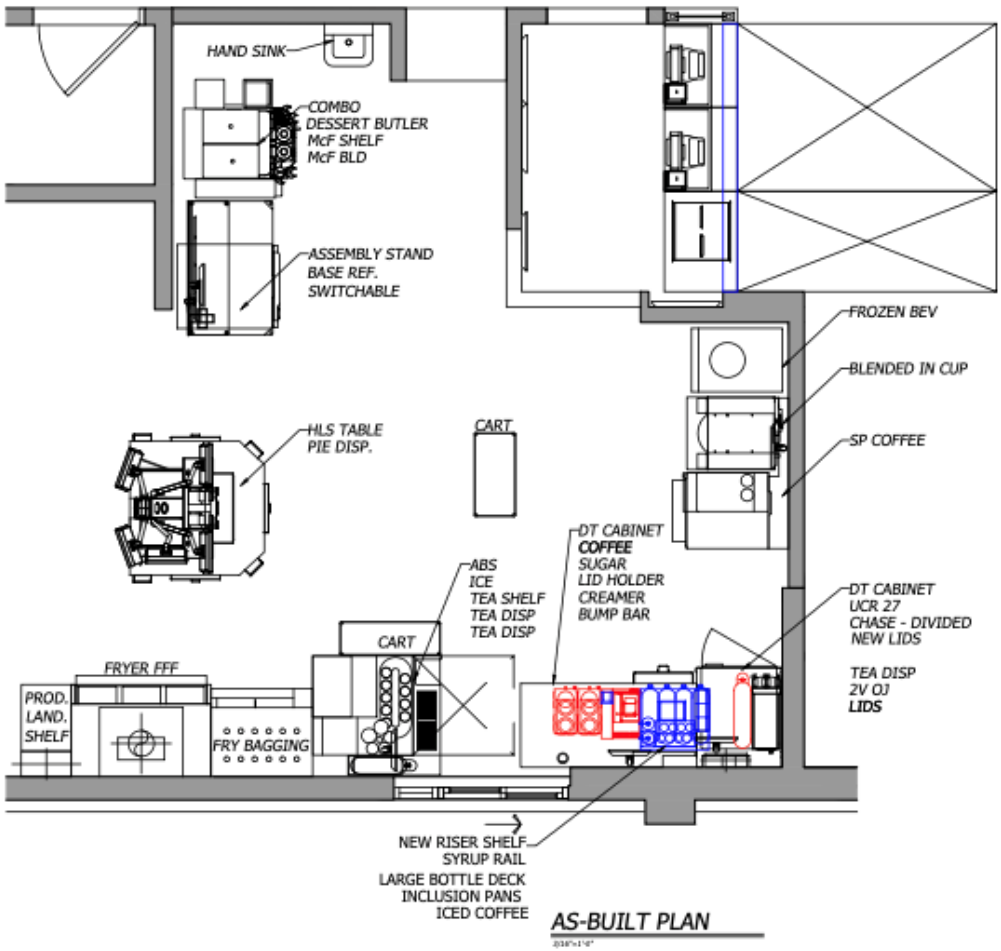


In-Store/Non-DT Layouts


Beverage Integration In-Store/Non-DT w/ Center Island Layout A

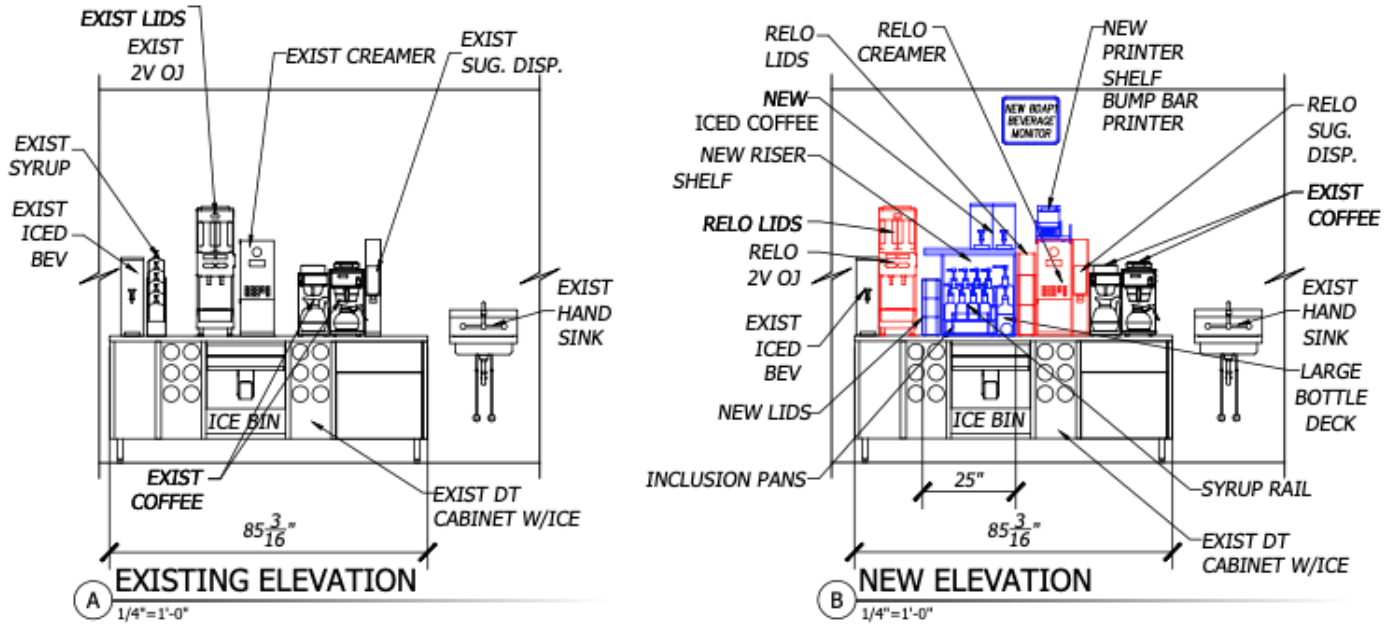

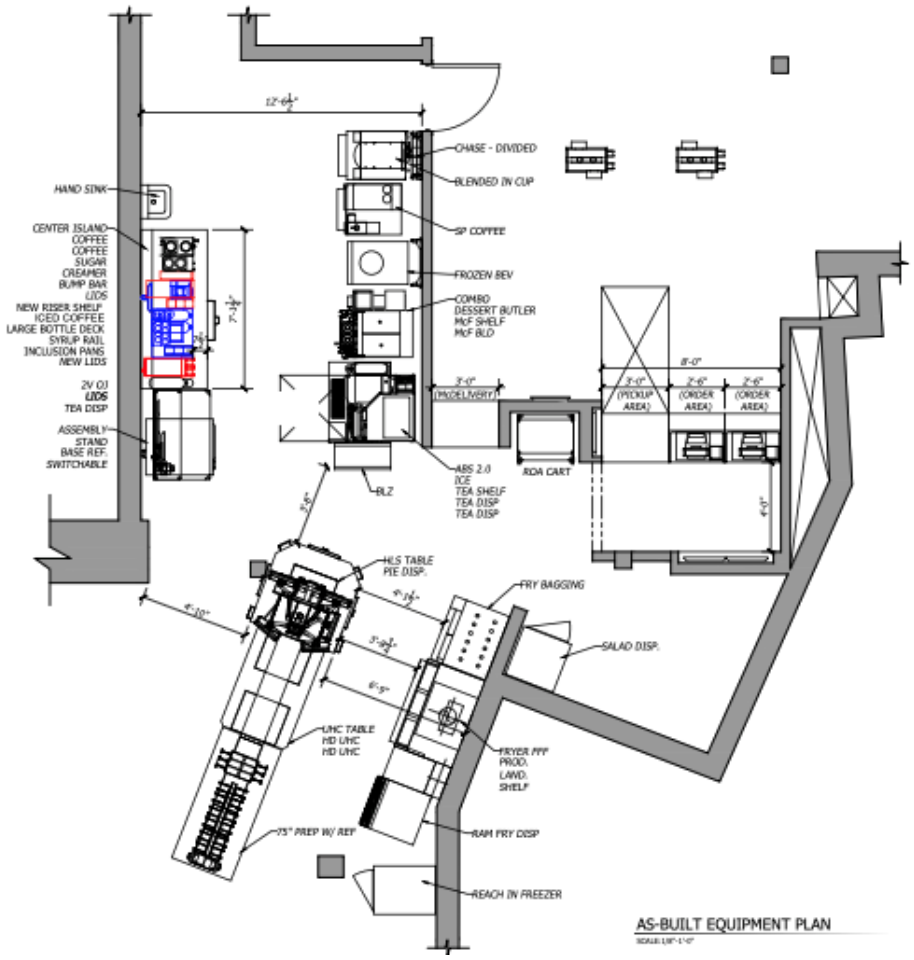


Beverage Integration In-Store/Non-DT w/ Center Island Layout B

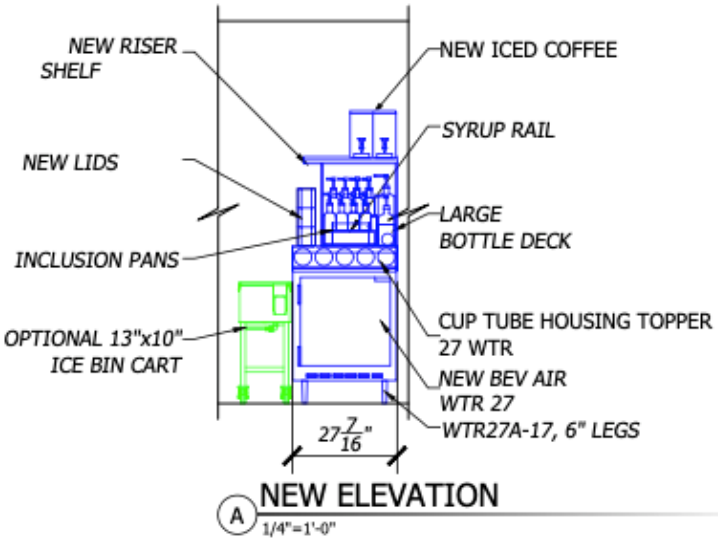


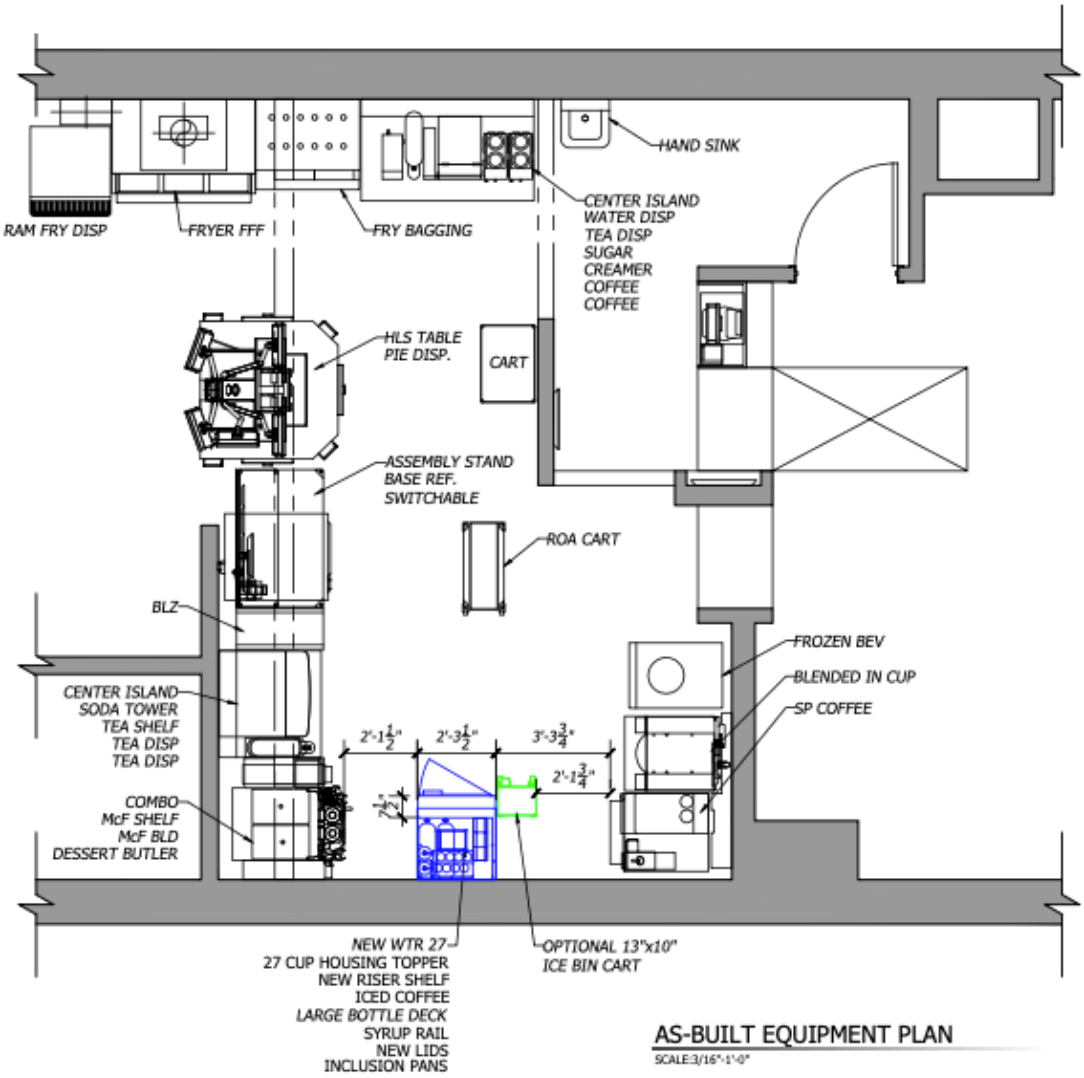

Beverage Integration In-Store/Non-DT w/ Center Island Layout C

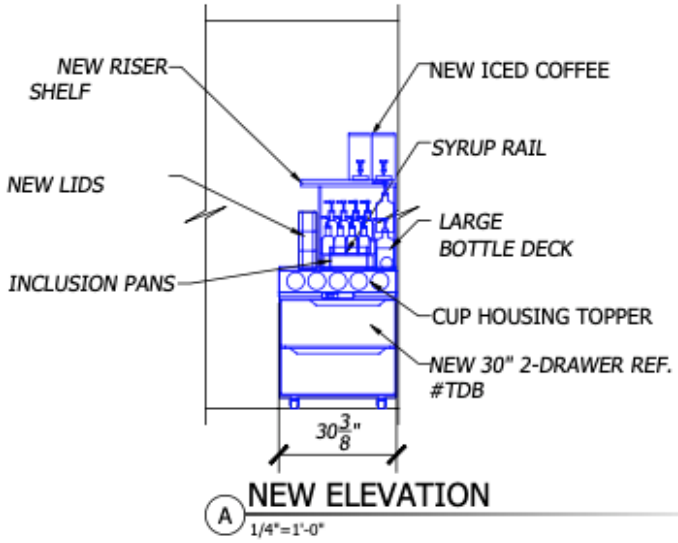


A NEW ELEVATION
1/4"=1'-0"

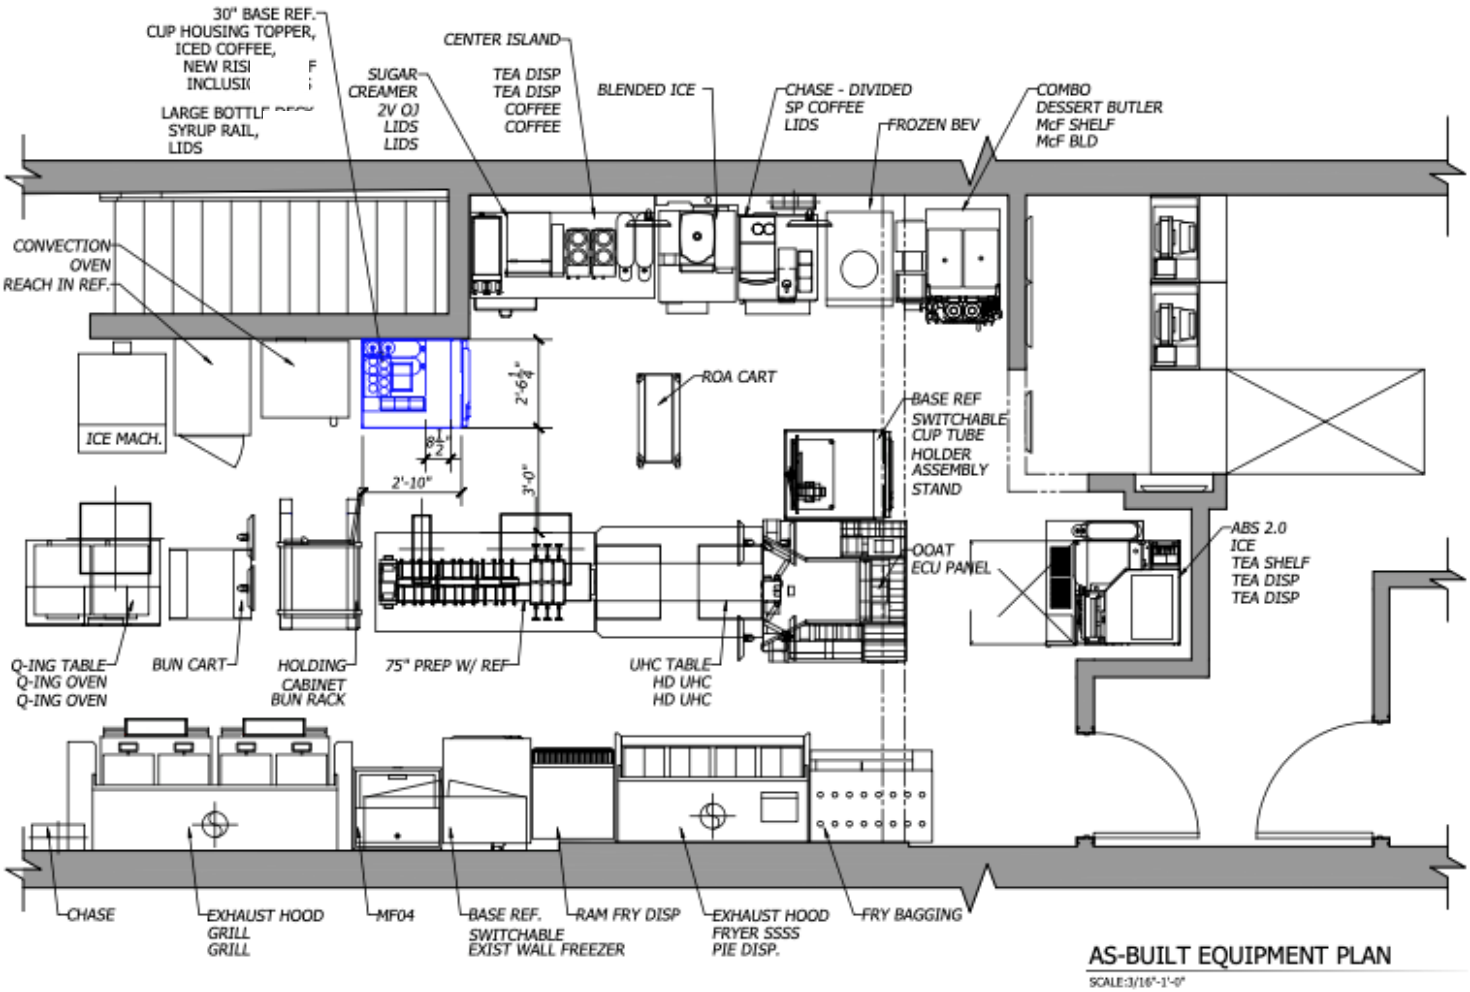



AS-BUILT EQUIPMENT PLAN
SCALE:3/16"-1'-0"


Beverage Integration In-Store/Non-DT w/ Center Island Layout D

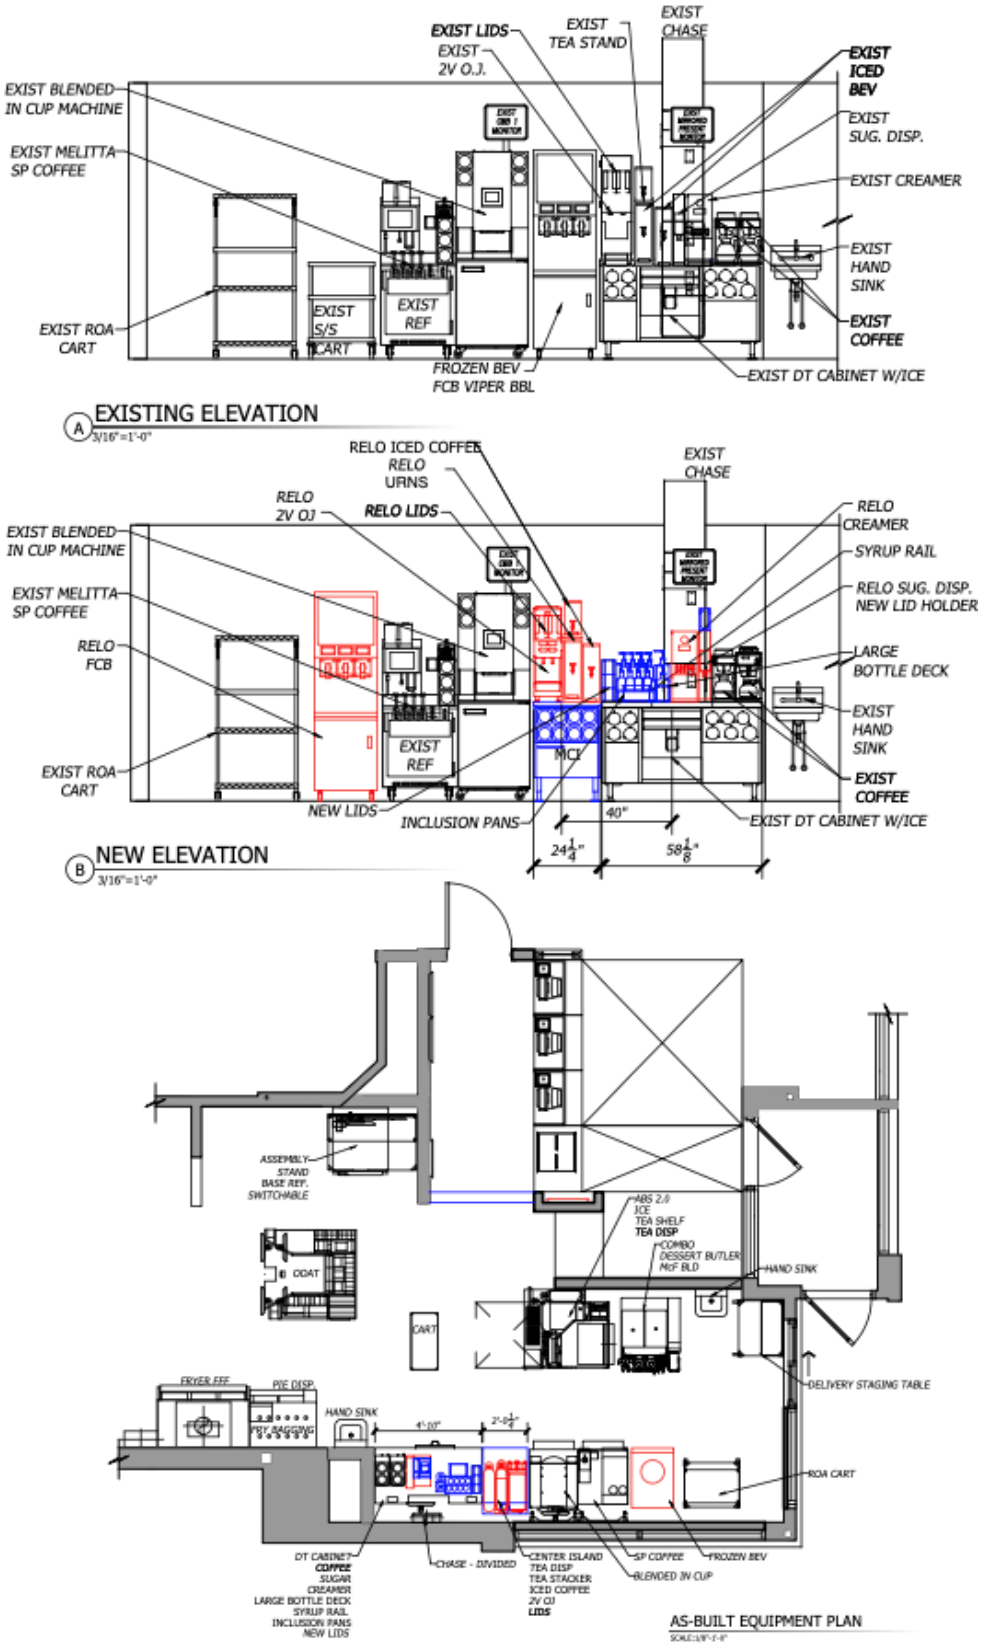


Beverage Integration In-Store/Non-DT w/ Center Island Layout E

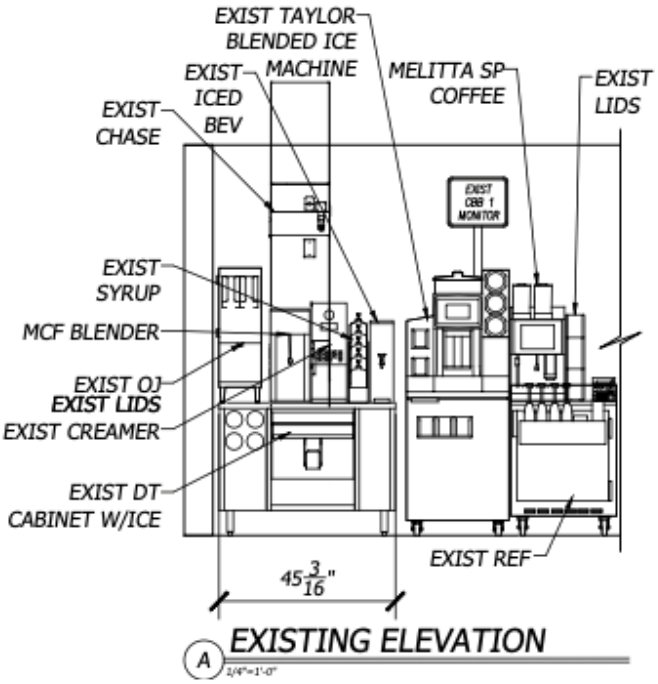


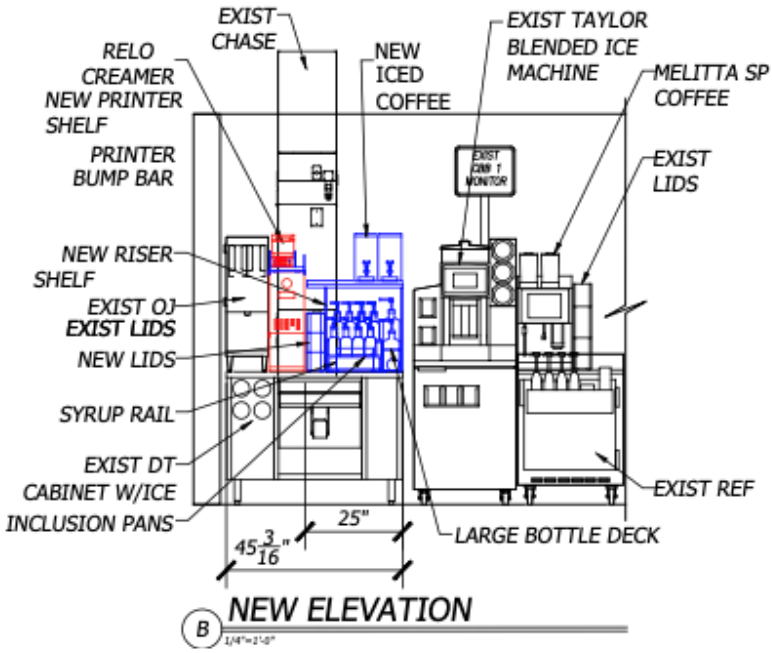

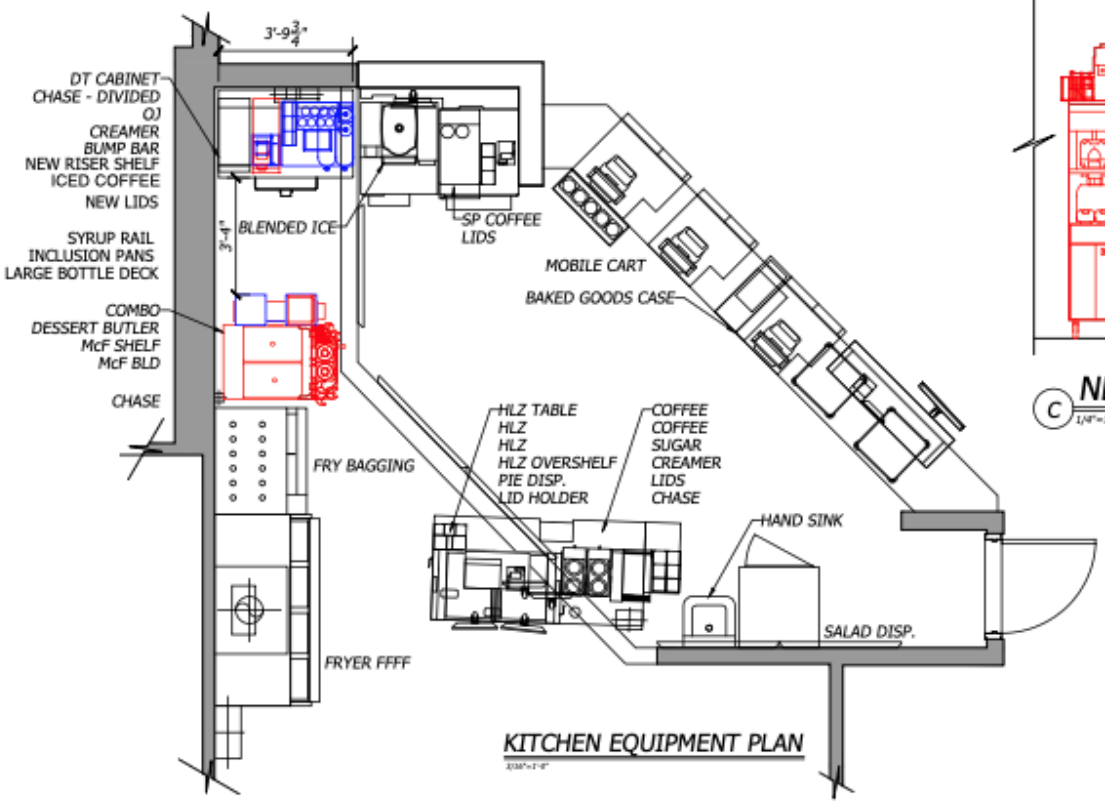


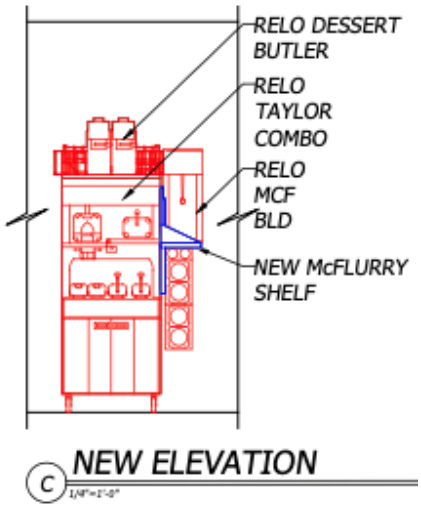


Beverage Integration In-Store/Non-DT w/ Center Island Layout F

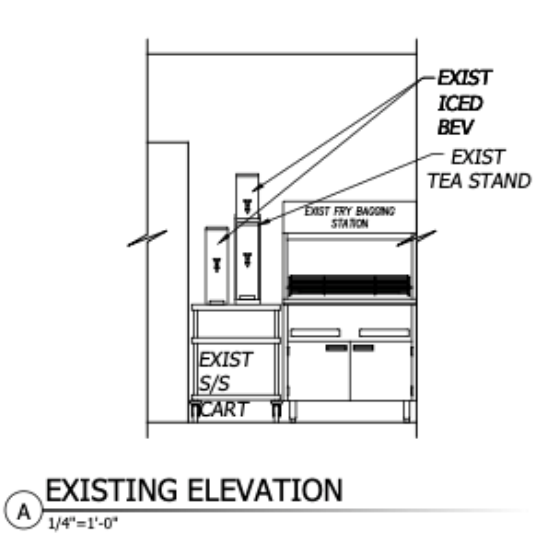

A EXISTING ELEVATION
1/4"=1'-0"

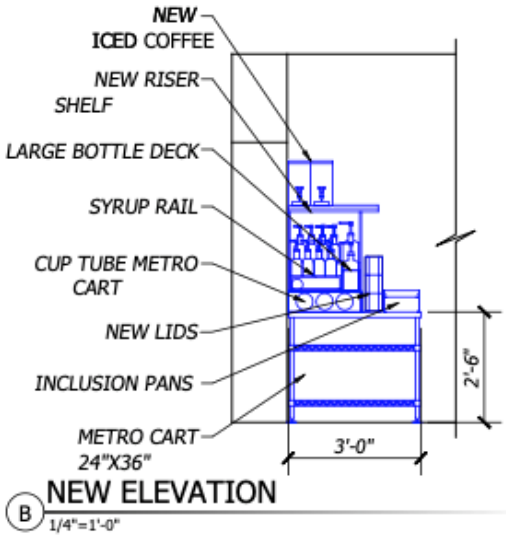



B NEW ELEVATION
1/4"=1'-0"

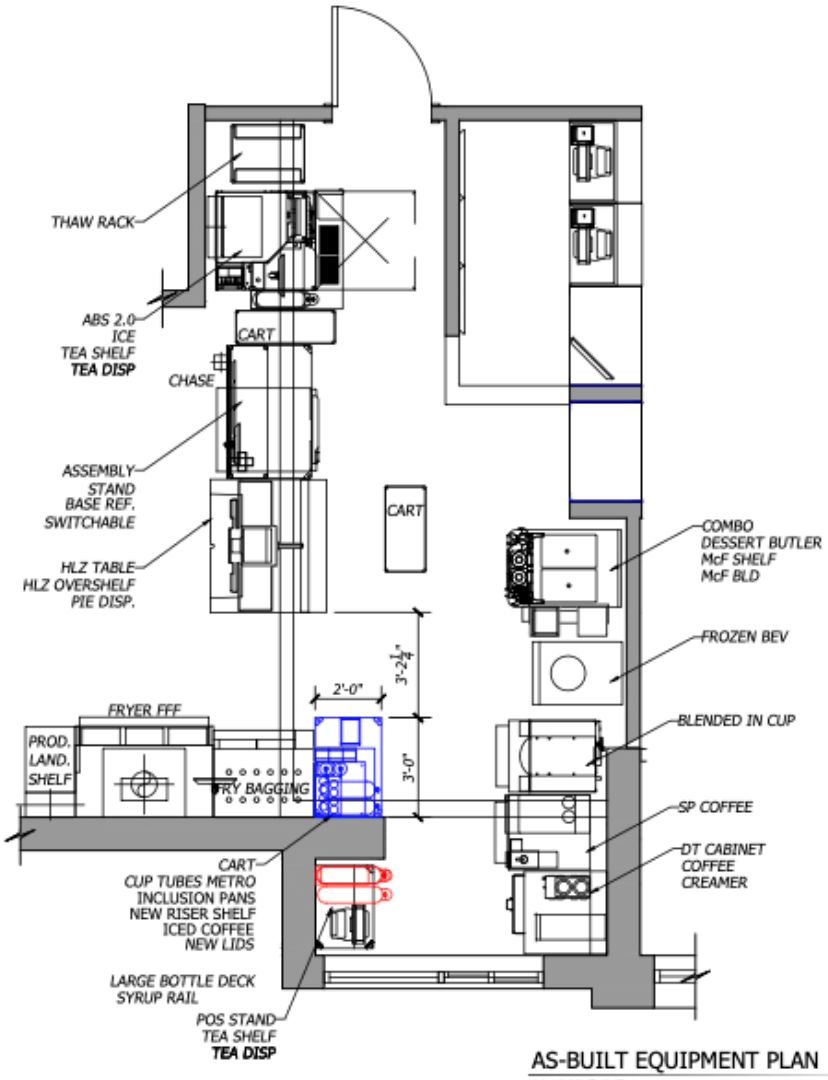

AS-BUILT EQUIPMENT PLAN
SCALE:3/16"-1'-0"


Beverage Integration In-Store/Non-DT w/ Center Island Layout G

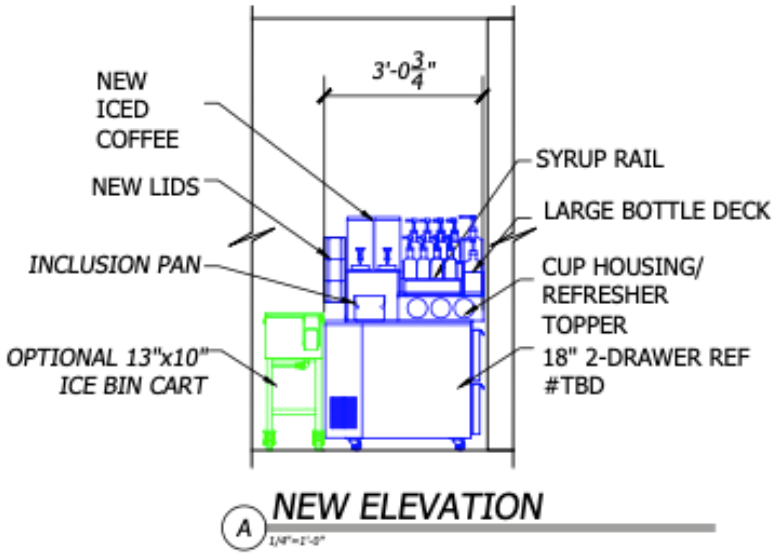

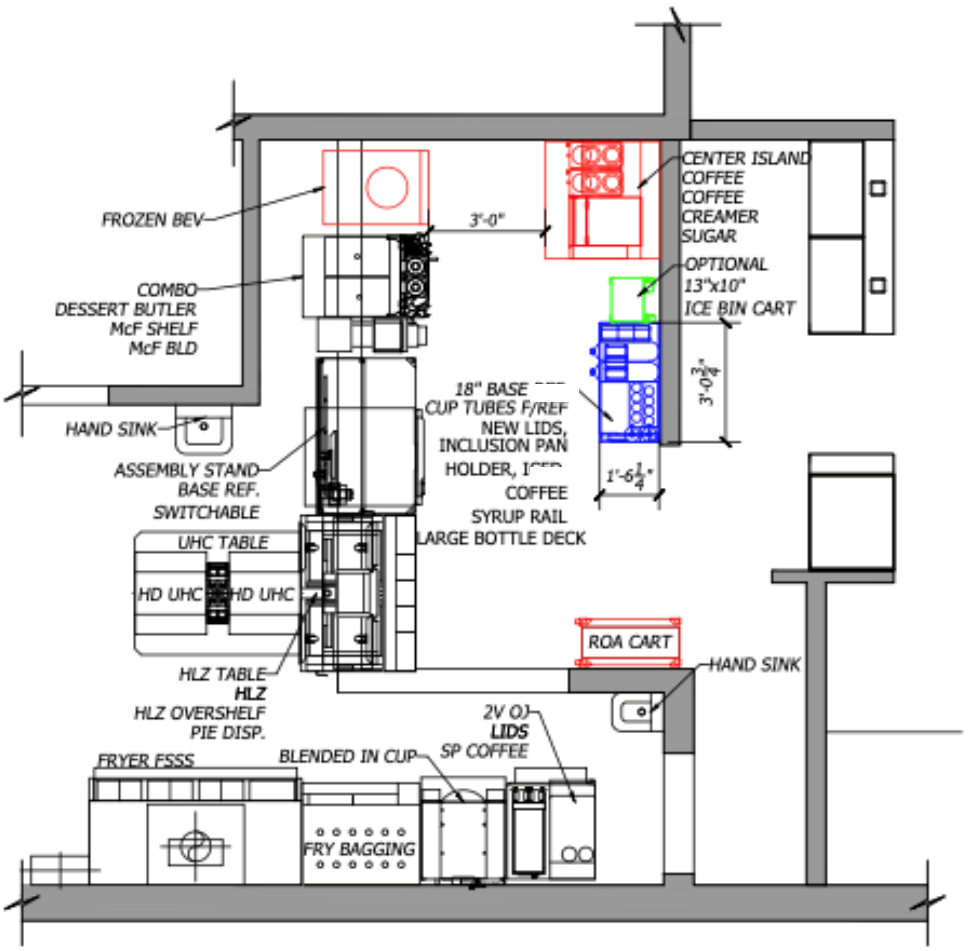


Gas Station/Oil Alliance

Beverage Integration Gas Station/Oil Alliance Layout A

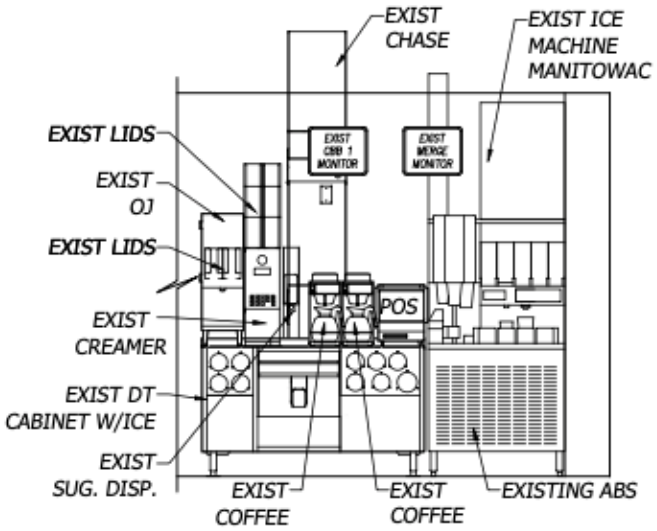



A EXISTING ELEVATION
1/4"=1'-0"

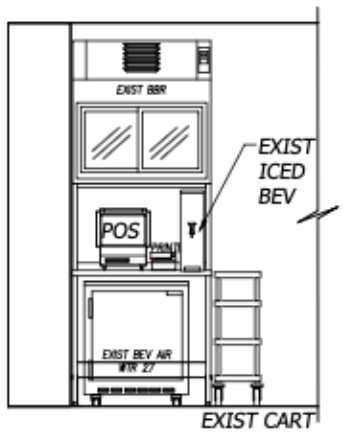

B DRIVE THRU ELEVATION
1/4"=1'-0"


NOTE: UNABLE PLACE A REFRESHER STATION HERE DUE TO SITE ONLY HAVING 2 COFFEE MACHINES. RECOMMENDATION OPTION IS TO REMOVE THE BBR STAND, INSTALL AN OFFLINE REFRIG SOLUTION. AVAILABLE SPACE WILL NEED TO BE REVIEWED

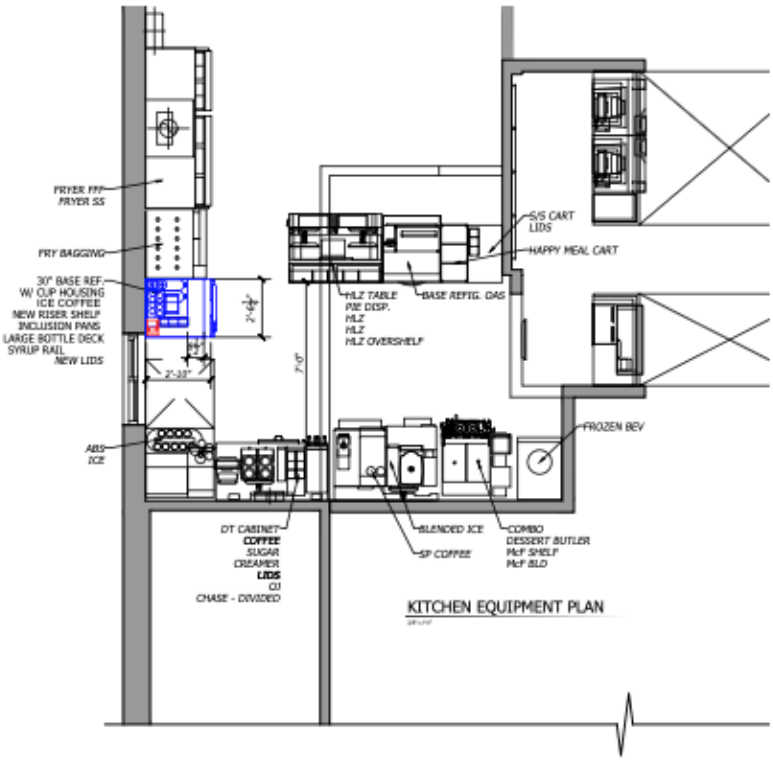


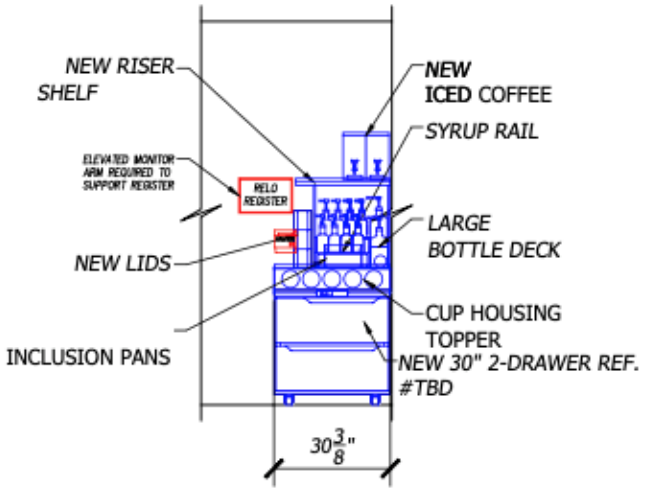


C NEW ELEVATION
1/4"=1'-0"

Beverage Integration Gas Station/Oil Alliance Layout B

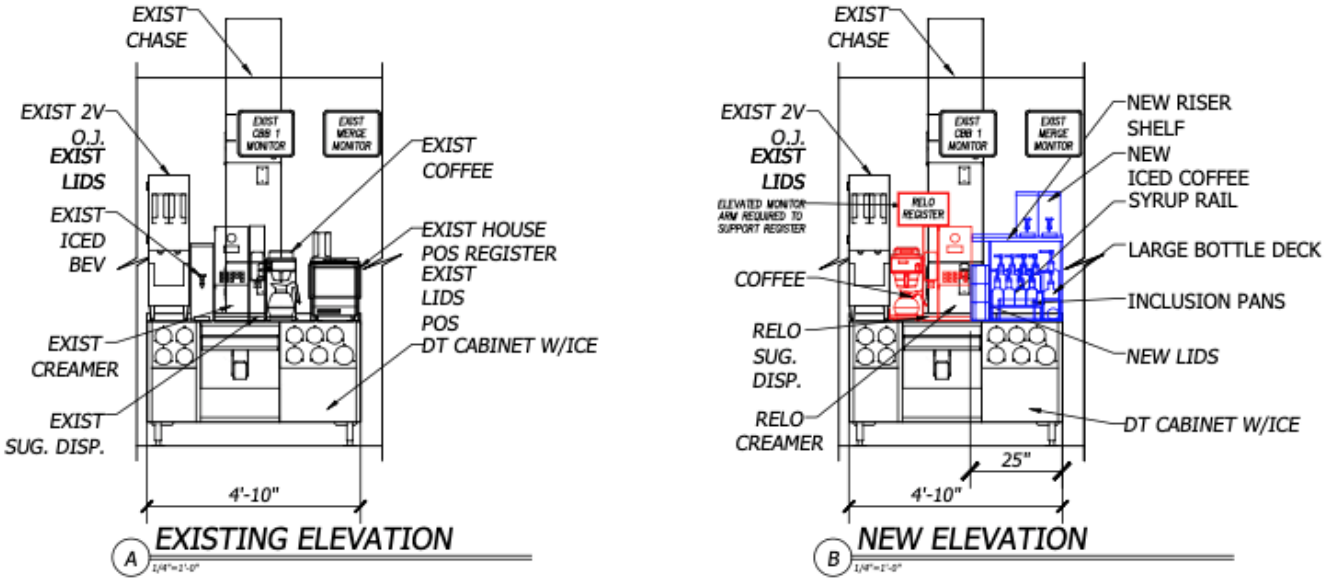


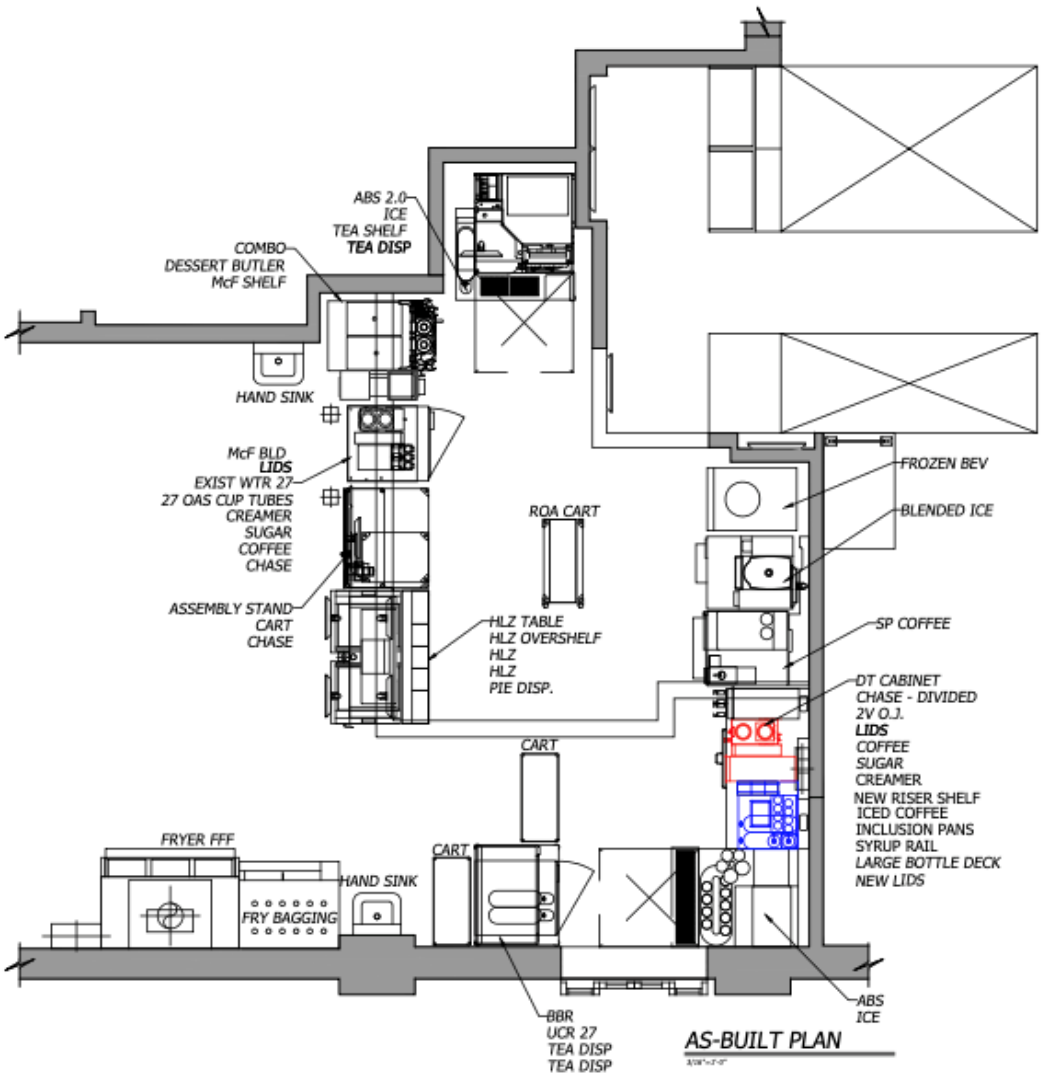


Beverage Integration Gas Station/Oil Alliance Layout C

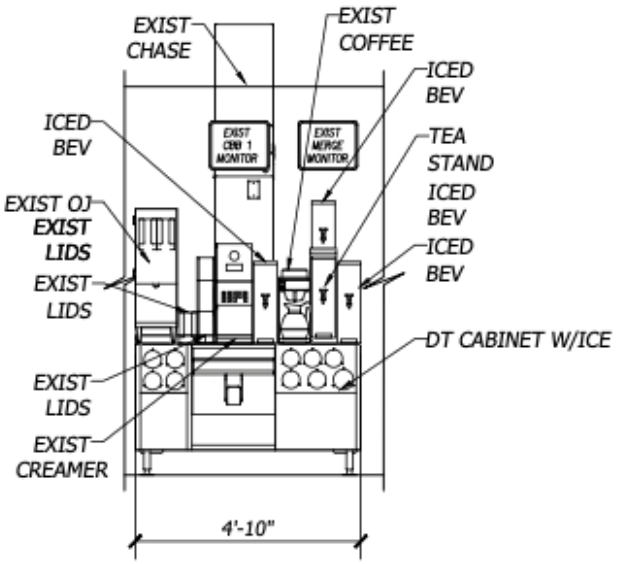

A EXISTING ELEVATION
1/4"=1'-0"

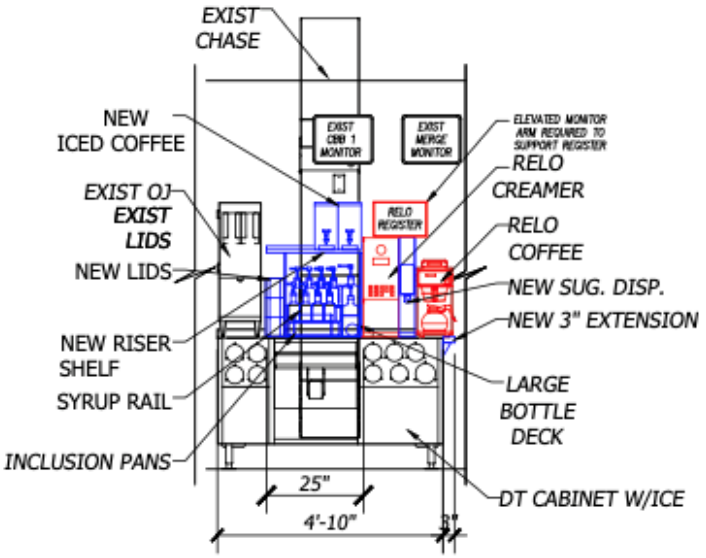


B NEW ELEVATION
1/4"=1'-0"

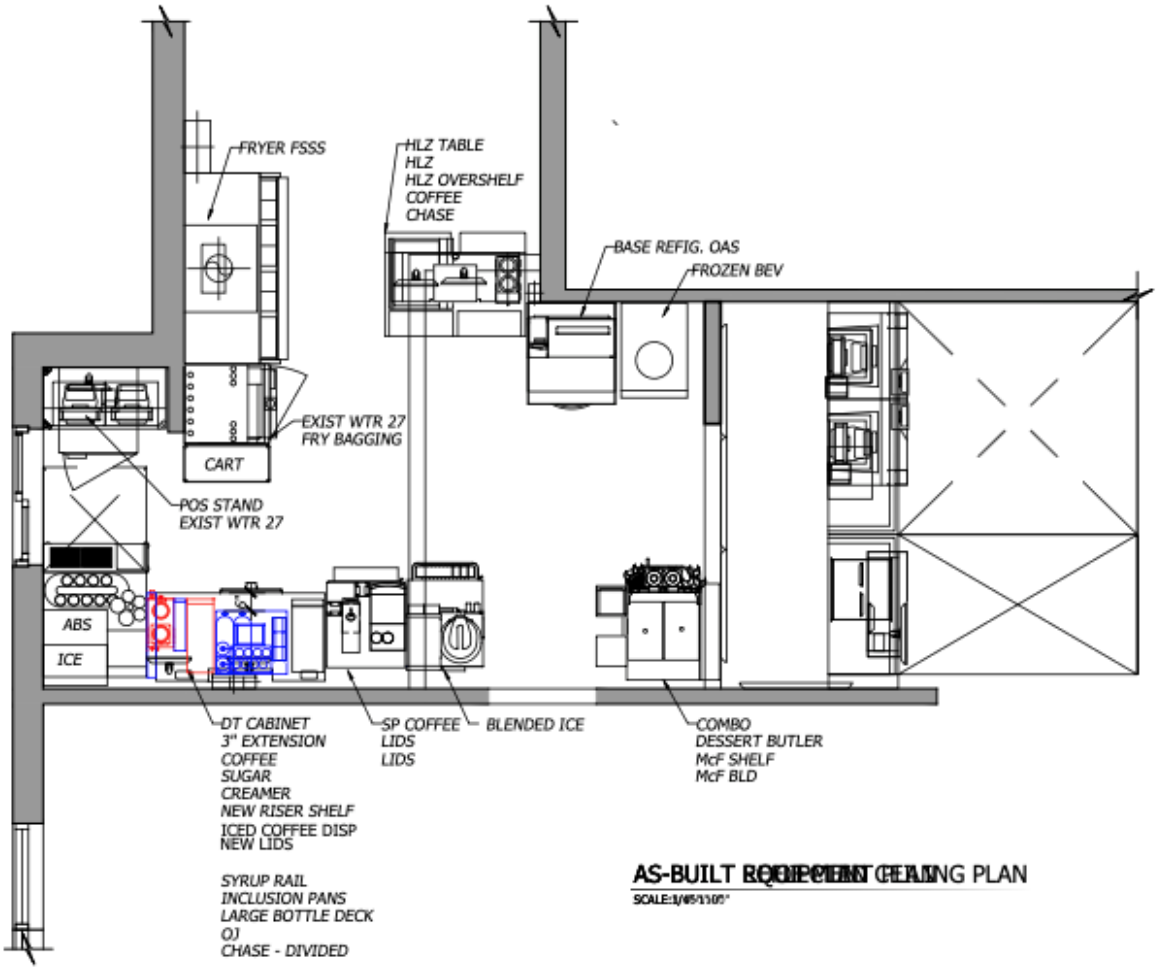


AS-BUILT EQUIPMENT PLAN
SCALE:1/4"=1'-0"

Beverage Integration Gas Station/Oil Alliance Layout D

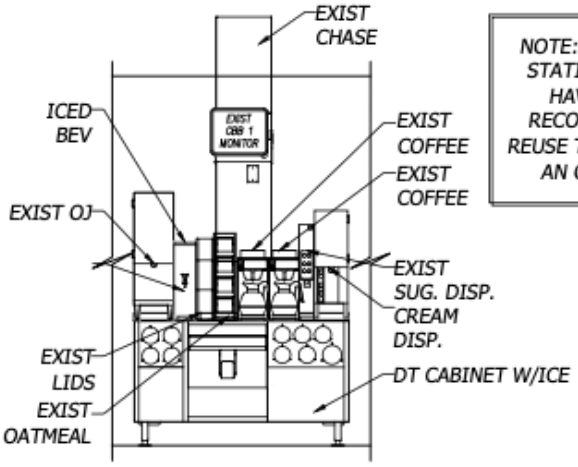


NOTE: UNABLE PLACE A REFRESHER STATION HERE DUE TO SITE ONLY HAVING 2 COFFEE MACHINES. RECOMMENDATION OPTION IS TO REUSE THE EXISTING WTR27, INSTALL AN OFFLINE REFRIG SOLUTION.

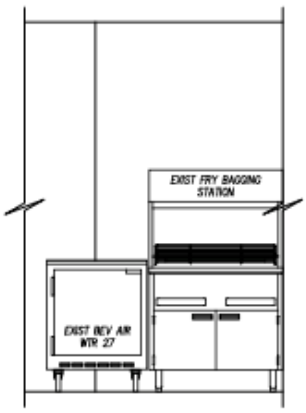


A EXISTING ELEVATION
1/4"=1'-0"

B EXISTING ELEVATION
1/4"=1'-0"

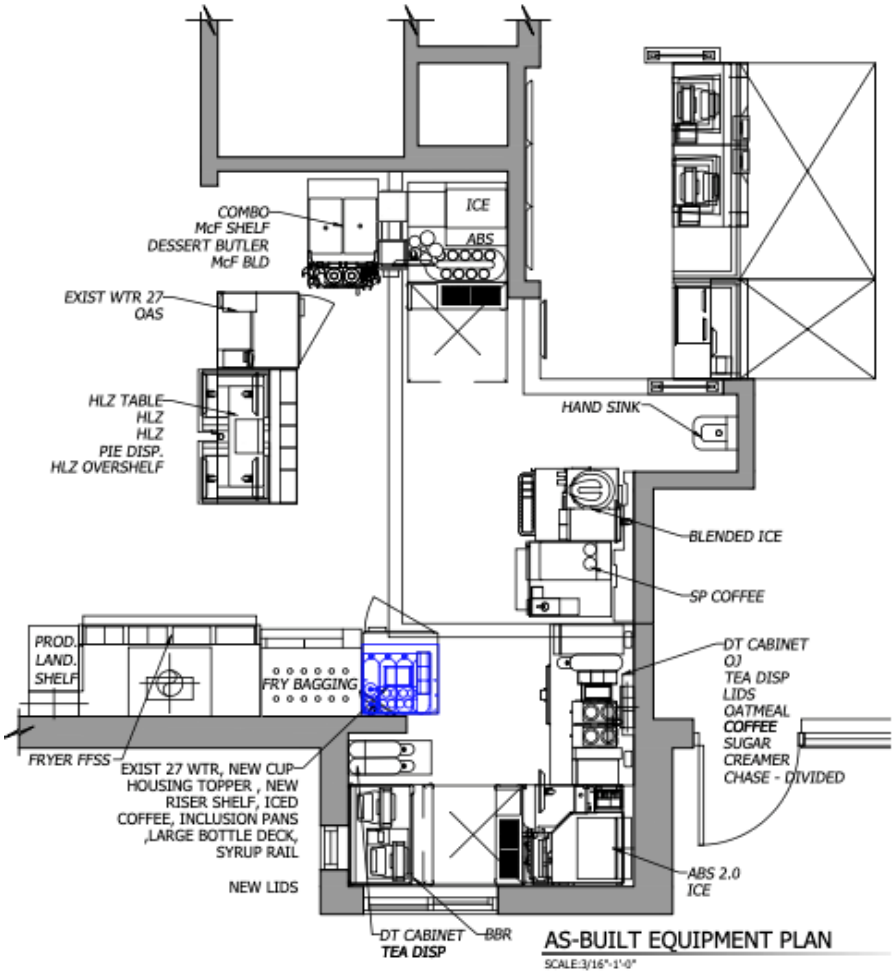


AS-BUILT EQUIPMENT PLAN
SCALE:3/16"-1'-0"

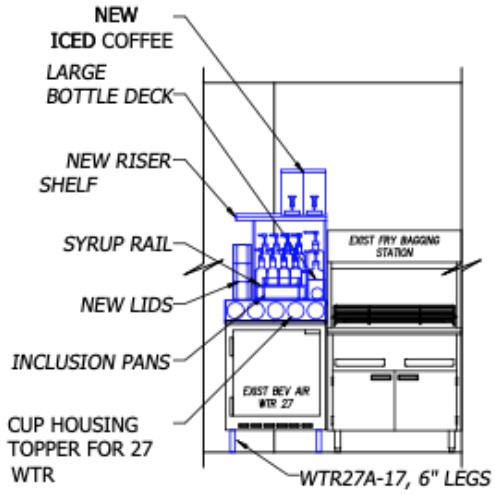



C NEW ELEVATION
1/4"=1'-0"

Walmart


Beverage Integration Walmart Layout A

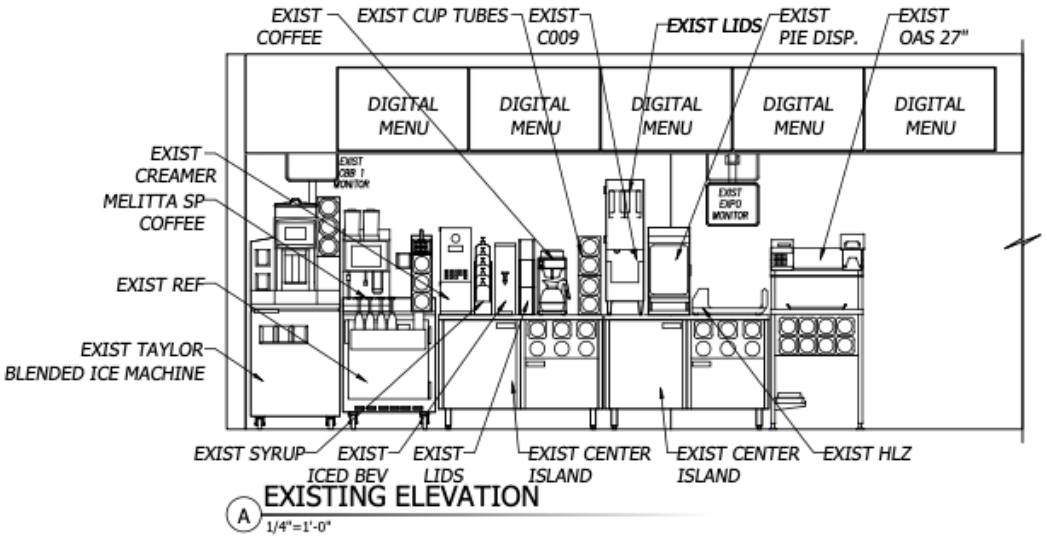


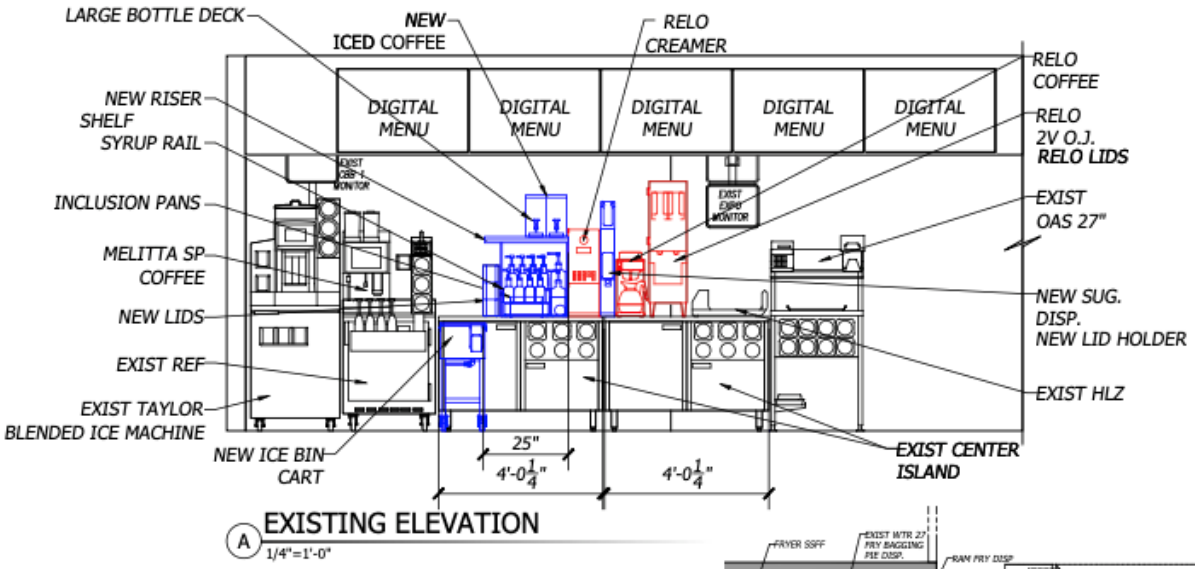

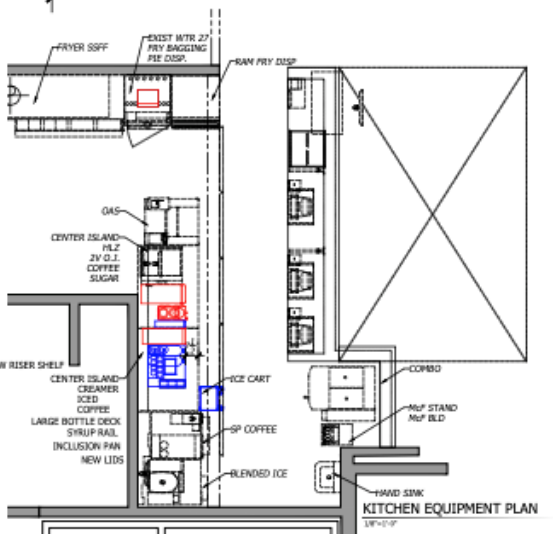



Beverage Integration Walmart Layout B

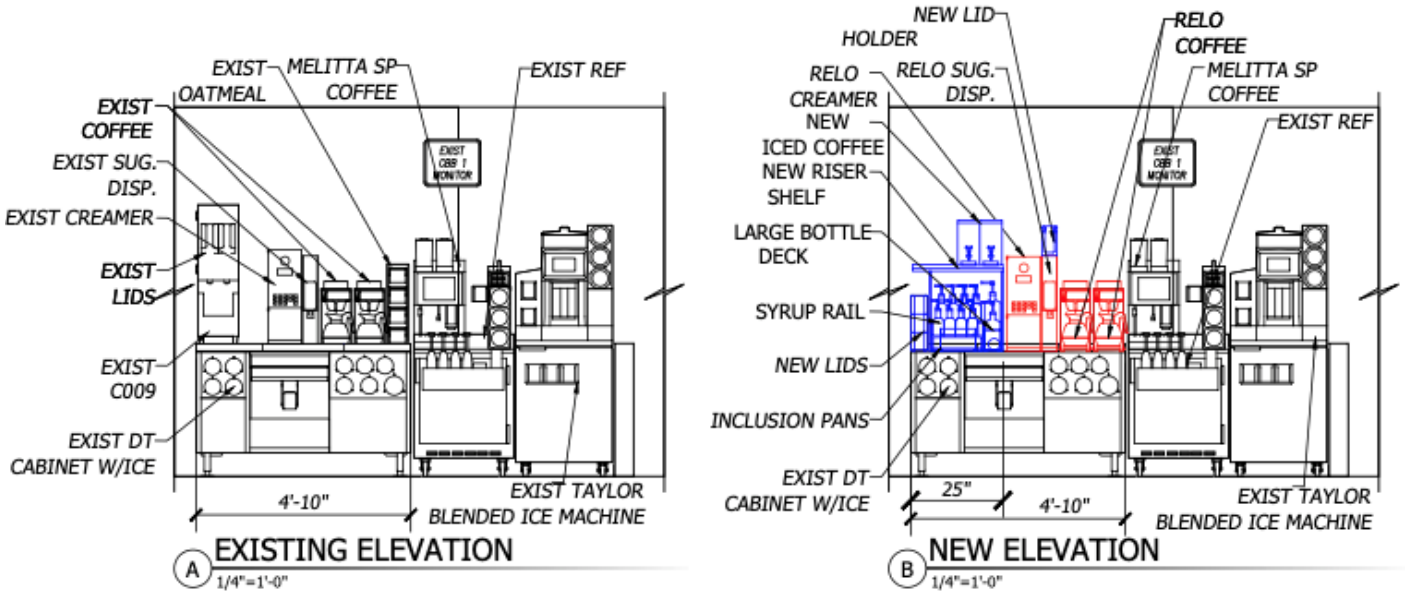


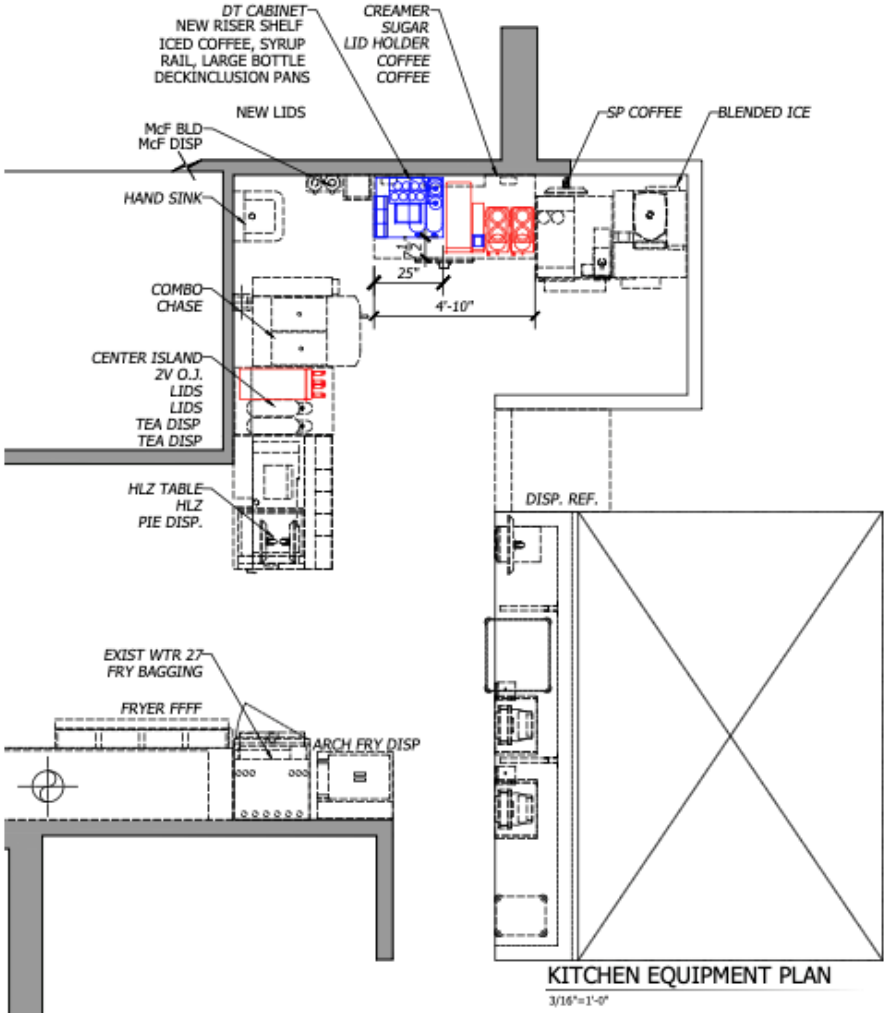


Beverage Integration Walmart Layout C

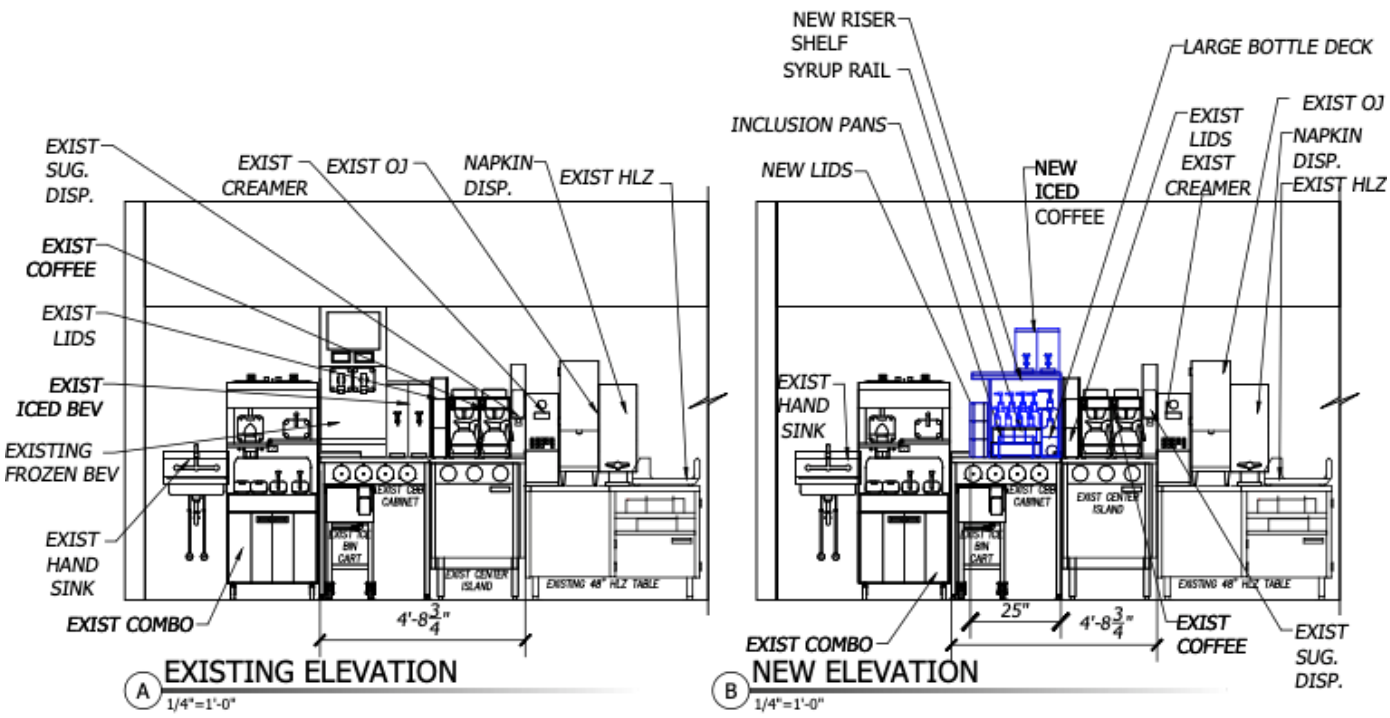

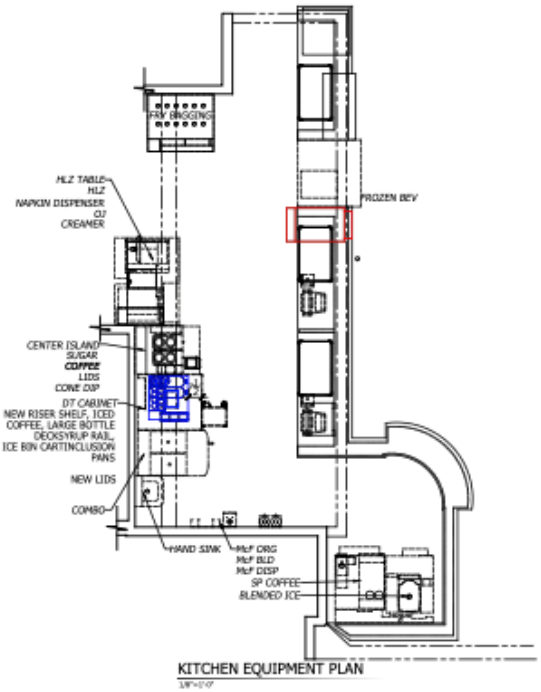


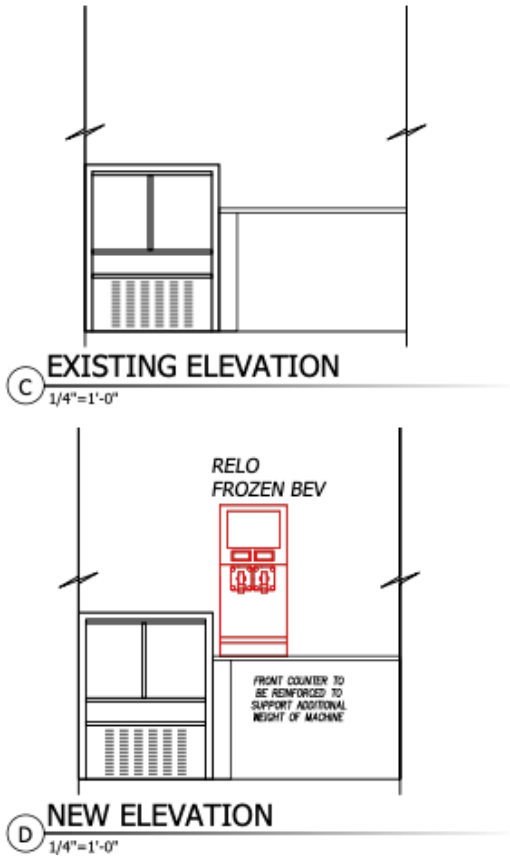


Beverage Integration Walmart Layout D

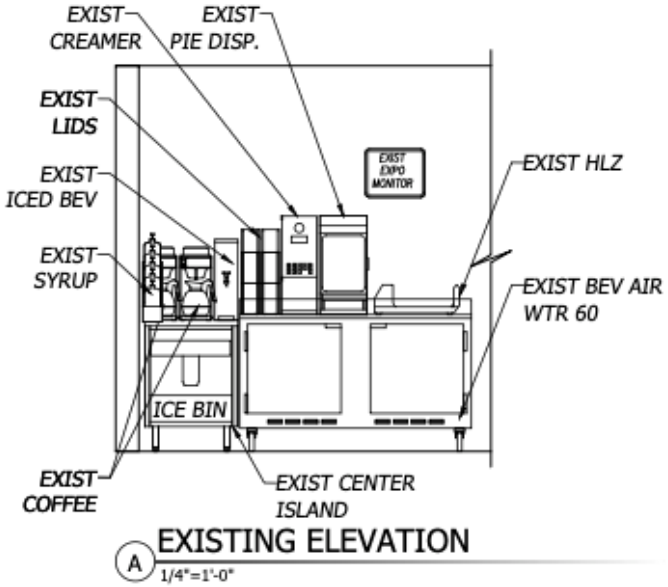

A EXISTING ELEVATION
1/4"=1'-0"

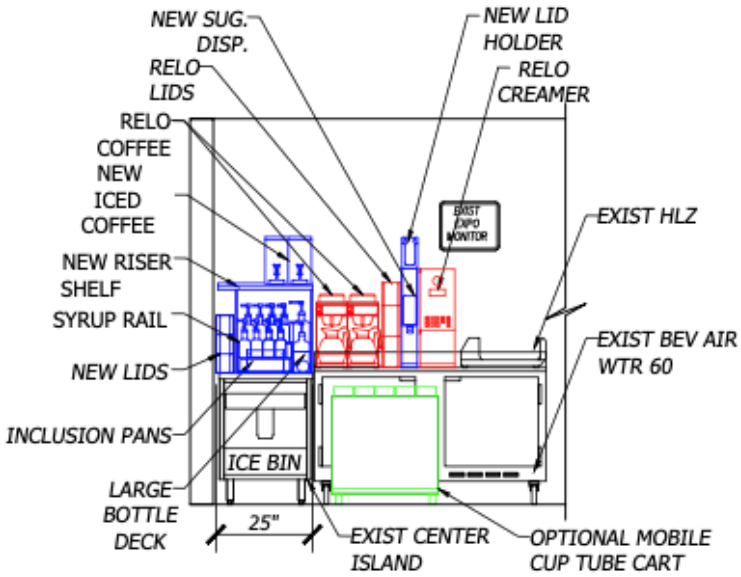


B NEW ELEVATION
1/4"=1'-0"

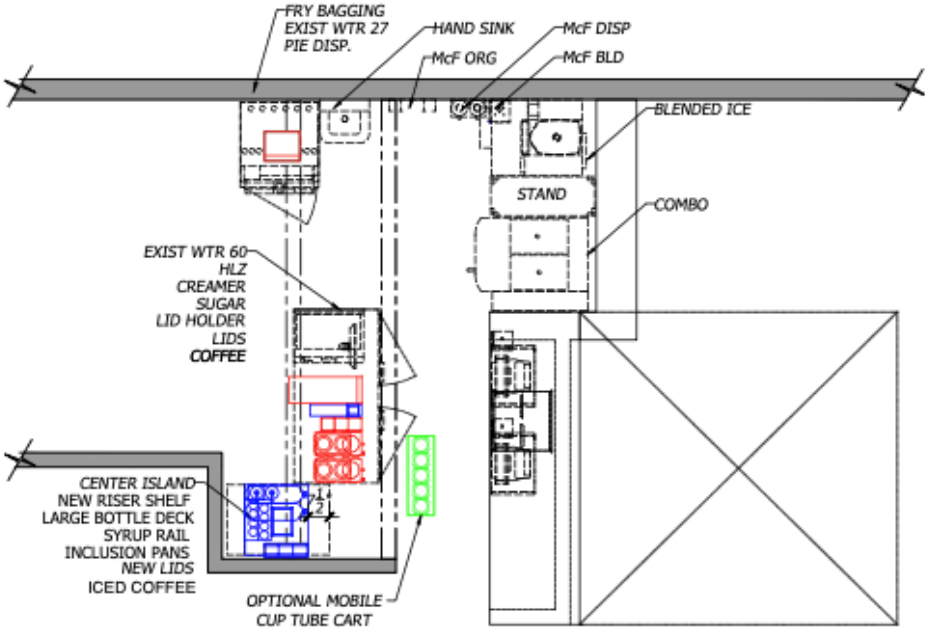


KITCHEN EQUIPMENT PLAN
3/16"=1'-0"


Beverage Integration Walmart Layout E

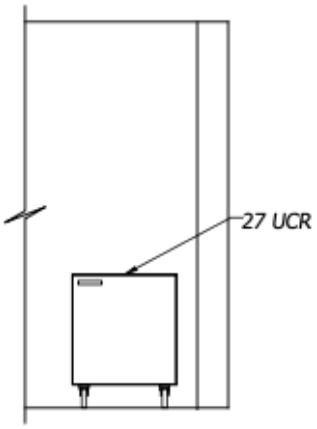

A EXISTING ELEVATION
1/4"=1'-0"

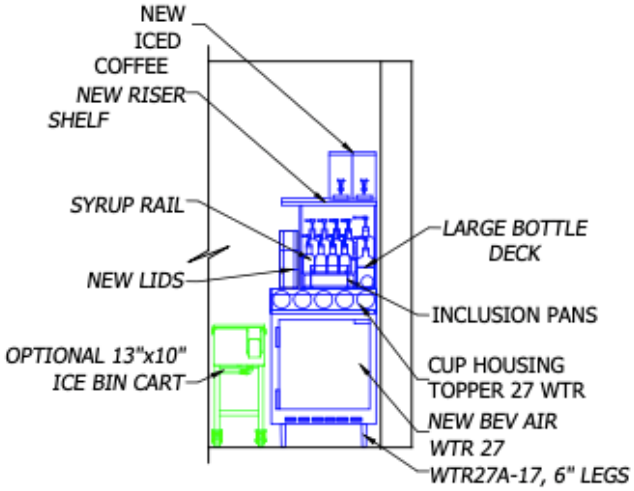

B NEW ELEVATION
1/4"=1'-0"

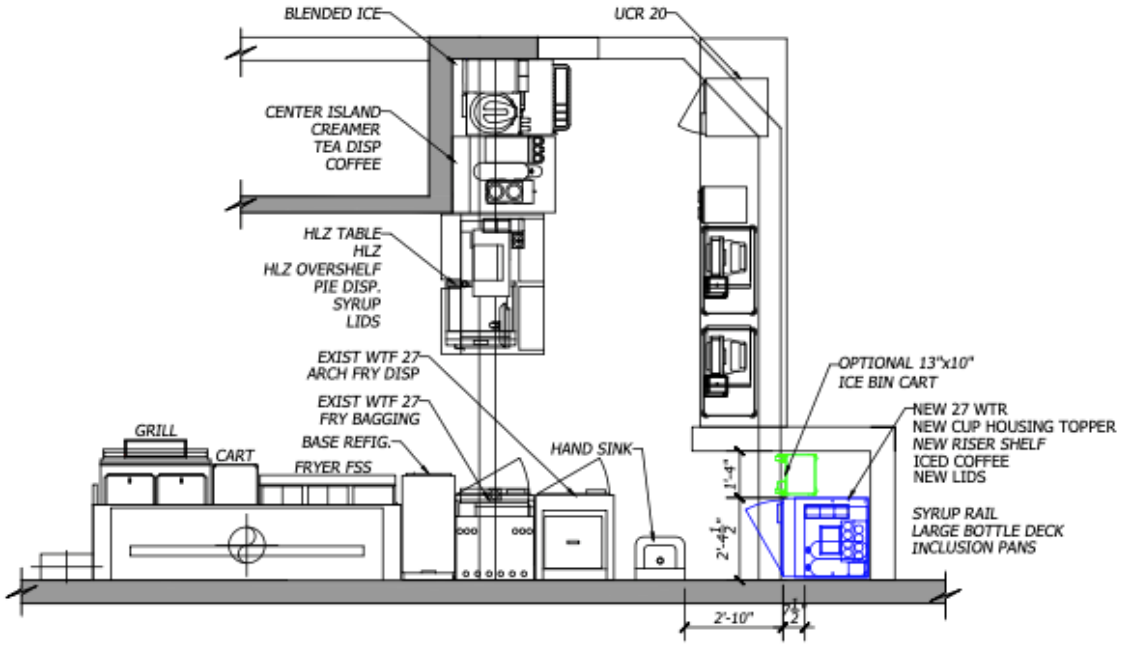

AS-BUILT EQUIPMENT PLAN
SCALE: 3/16"=1'-0"